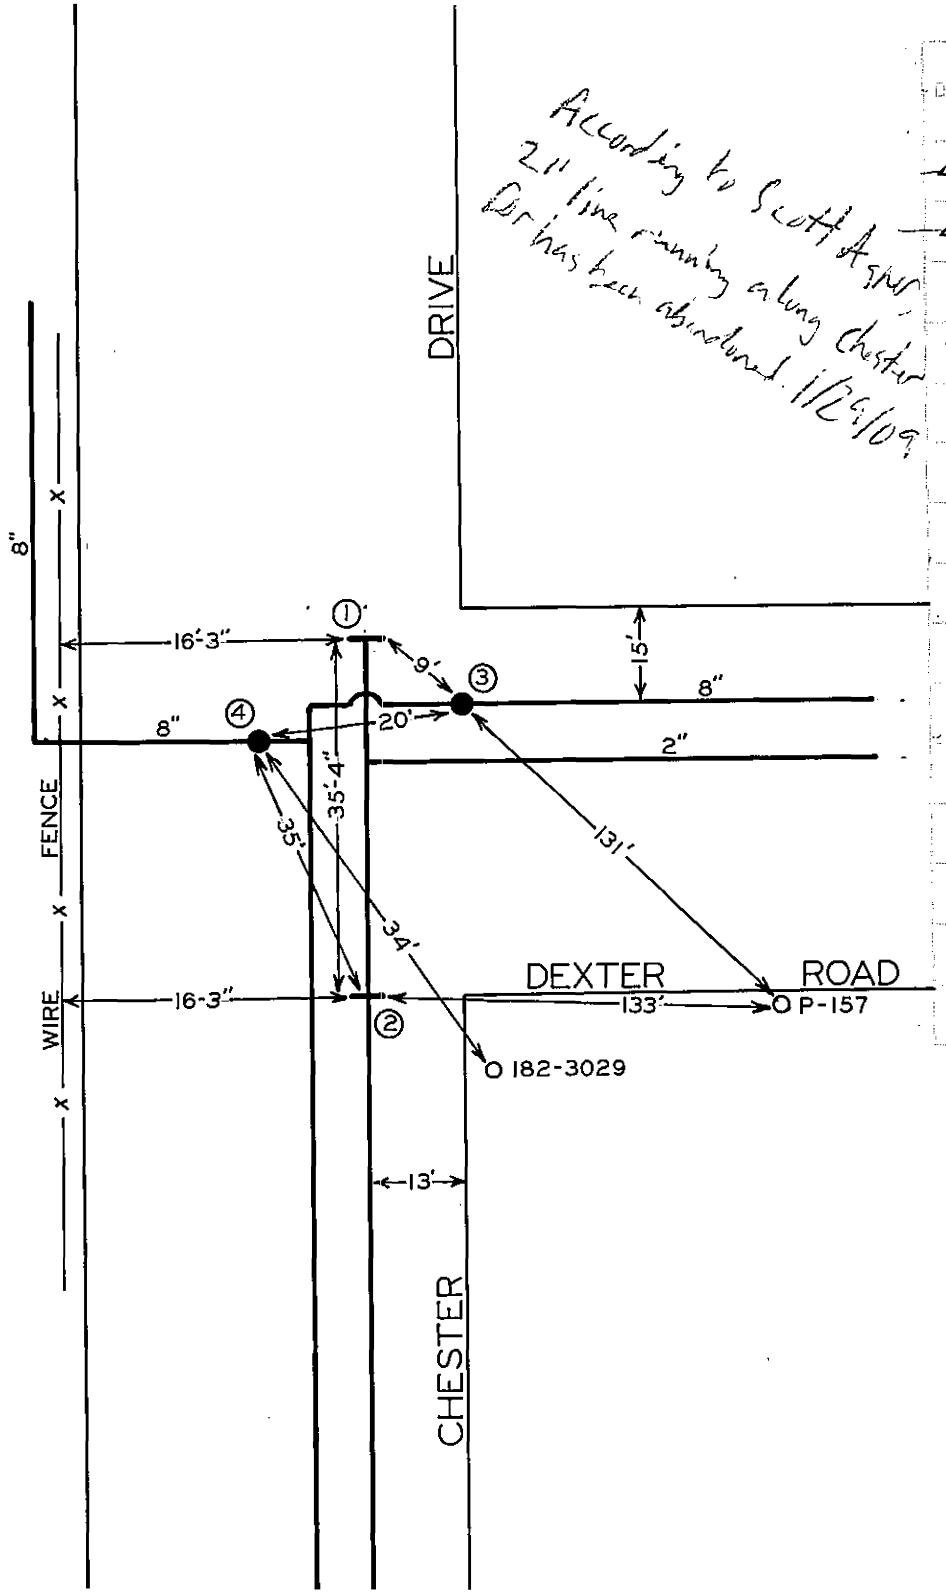

According to Scott Agnew, 2" line running along Chester Dr has been abandoned. 1/29/09

DATE	POLE	SIZE	BRAND	GROUP	ATT
~~47~~	~~1~~	~~2"~~		~~L~~	~~9 1/2~~
~~47~~	~~2~~	~~2"~~		~~L~~	~~9~~
	3	8"			
72	4	8"	MUELLER	R	27
	1	17'-S	N.P.L.		
	2	0	S.P.L.		
	3	0	E.P.L.		
	4				

CHESTER DRIVE &
DEXTER ROAD N.E.

19 Roanoke County