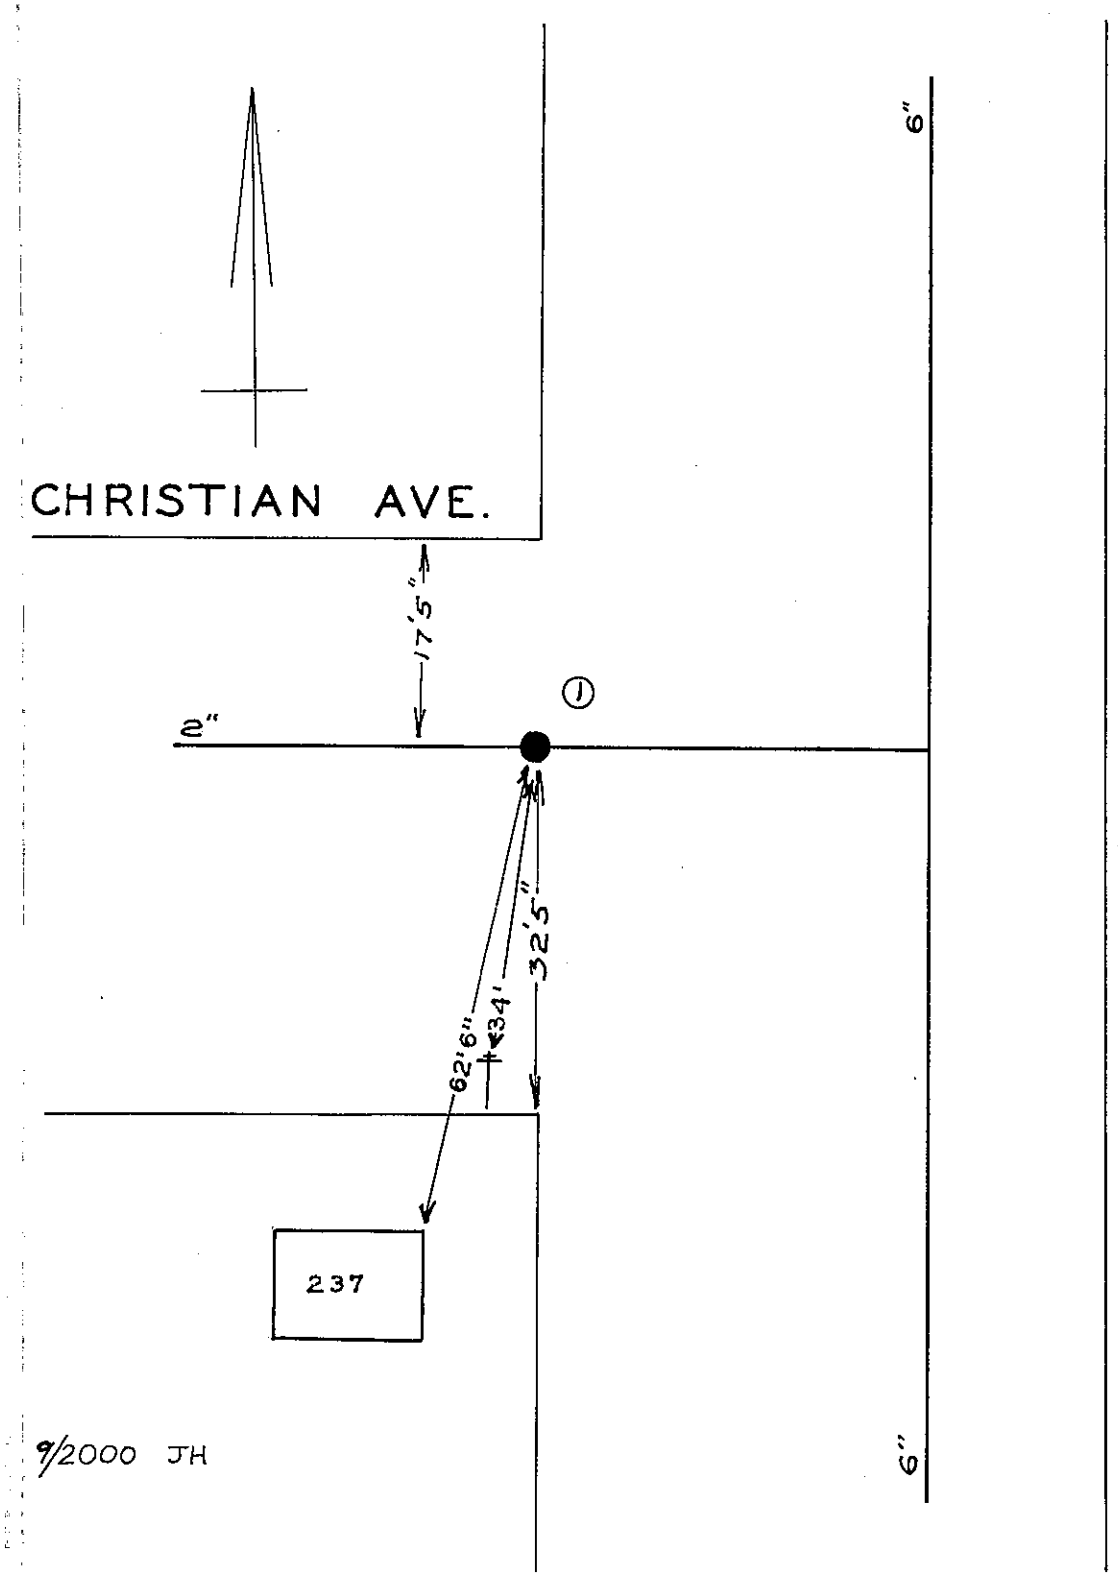

HOLMES STREET

DATE	NO.	SIZE	MAKE	OPEN	TURNS
1956	1	2"	DARLING	R	8
	1	0	WPL		

CHRISTIAN AVE. &
HOLMES ST.

319, 328

N. E.