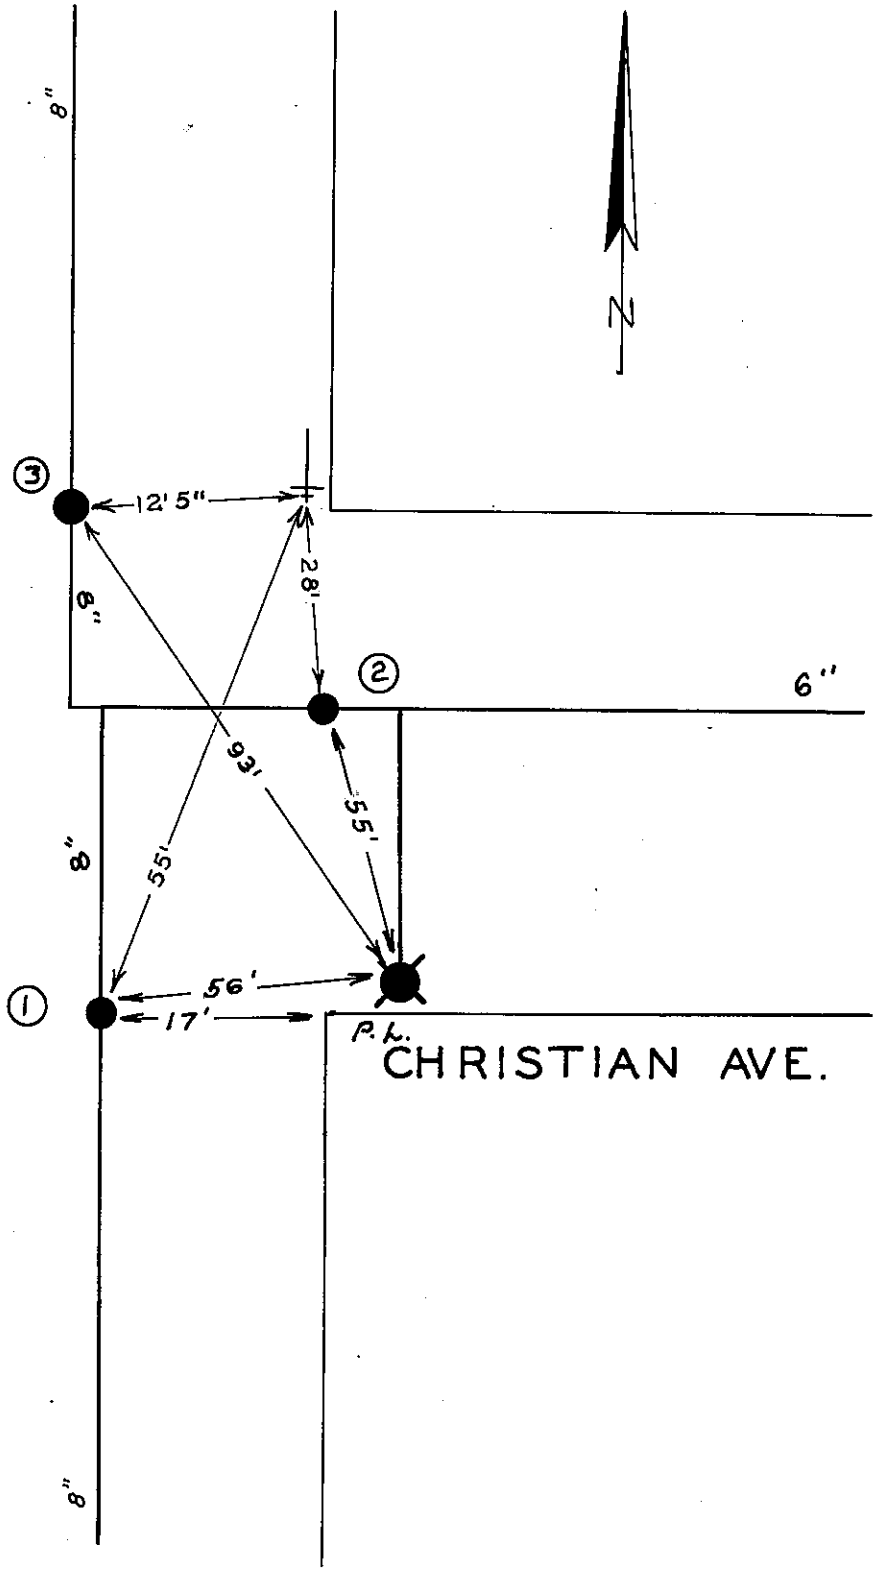


| DATE | NO. | SIZE | MAKE | OPEN | TURNS |
|---|---|---|---|---|---|
| 1955 | 1 | 8" | MUELLER | R | 27 |
| 1955 | 2 | 6" | MUELLER | R | 21 |
| 1956 | 3 | 8" | MUELLER | R | 27 |
| | | | | | |
| | | | | | |
| | | | | | |
| | | | | | |
| | | | | | |
| | | | | | |
| | | | | | |
| | | | | | |
| | | | | | |
| | 1 | 0 | SPL | | |
| | 2 | 0 | EPL | | |
| | 3 | 0 | NPL | | |

CITY OF ROANOKE — WATER DEPT.

VALVE DIAGRAM

CHRISTIAN AVE. &

OAKLAND BLVD. N.E. OR

N. W.

SEC. MAP 210-319

DATE PAGE NO.

10/2000 JH