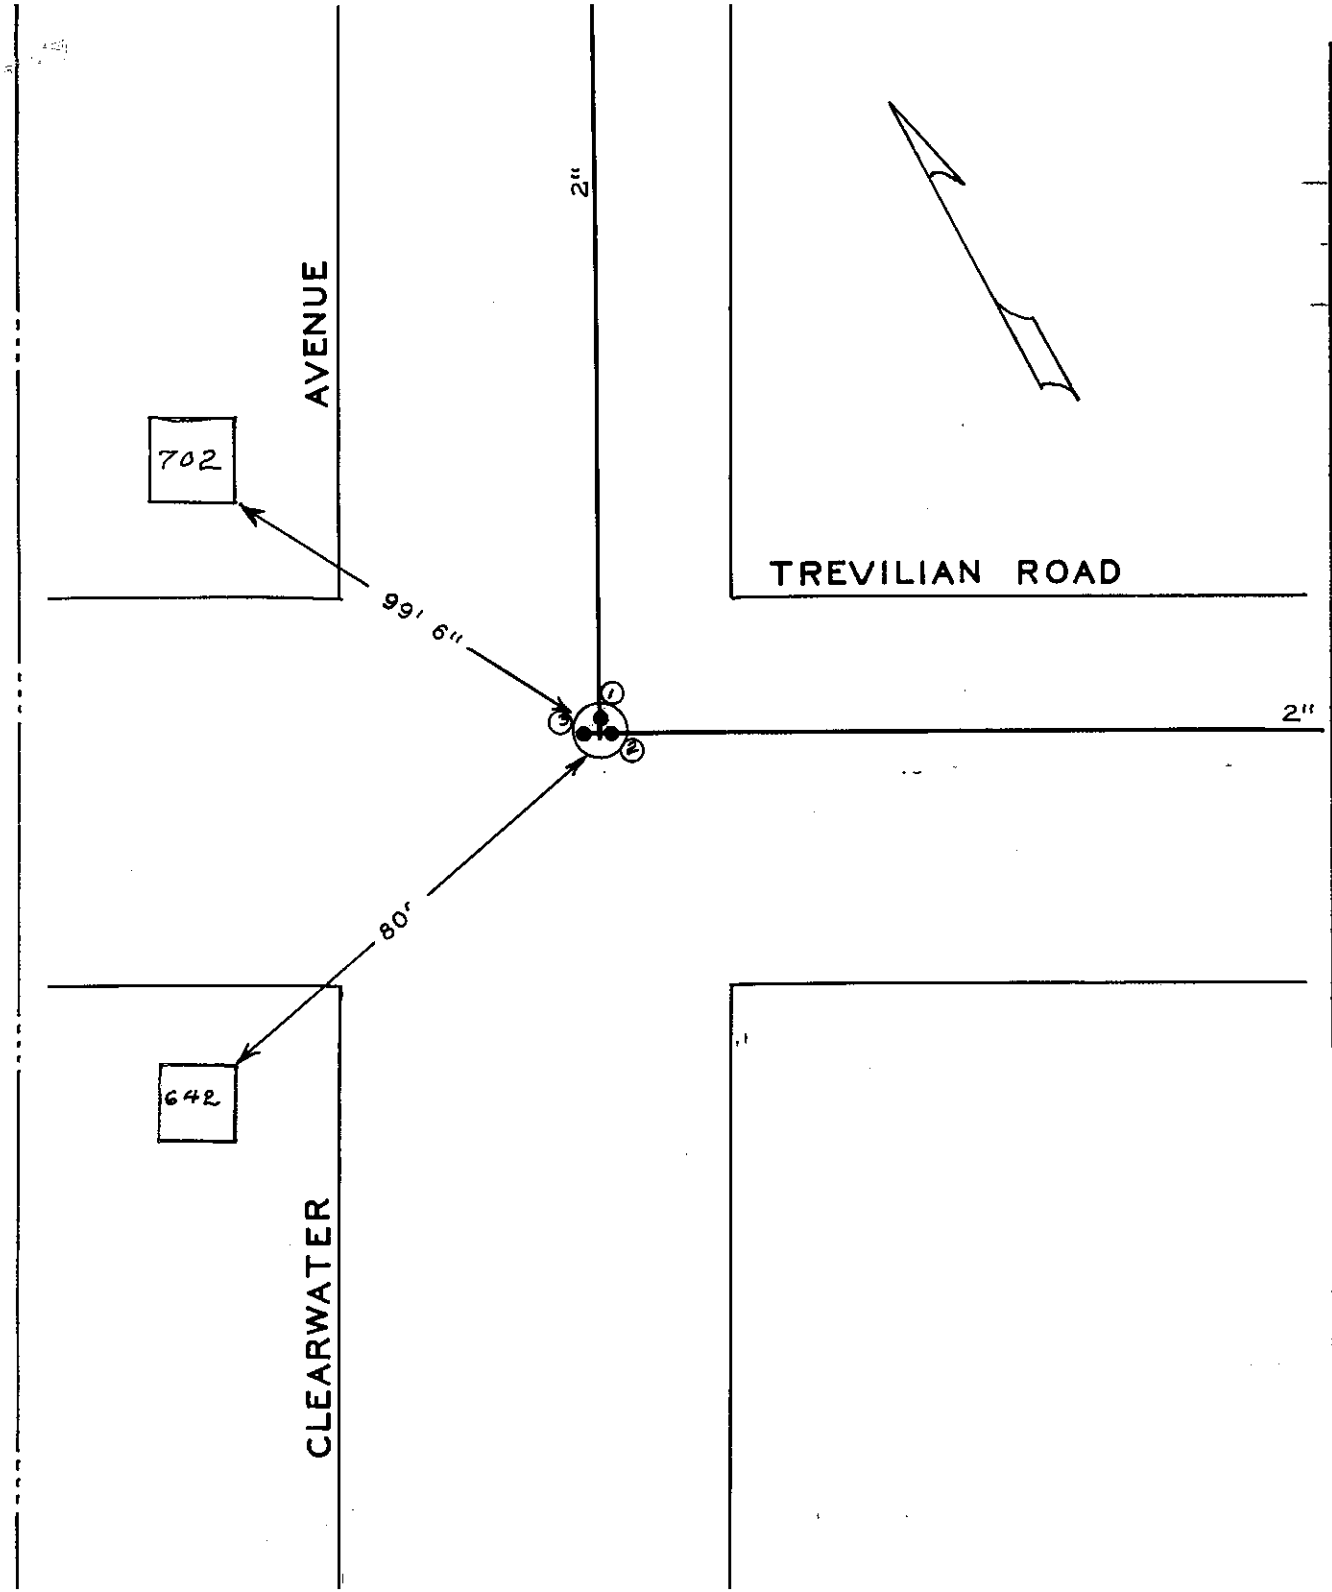

DATE	NO.	SIZE	MAKE	OPEN	TURNS
~~9-67~~	~~1~~	~~2"~~	~~DARLING~~	~~R~~	
~~9-67~~	~~2~~	~~2"~~	~~DARLING~~	~~R~~	
~~9-67~~	~~3~~	~~2"~~	~~MISC.~~		

all of 2" main abandoned
replaced w/ 8" main

CITY OF ROANOKE — WATER DEPT.

VALVE DIAGRAM

CLEARWATER AVENUE &
TREVILIAN ROAD N.E.

SEC. MAP 59 Roanoke County

DATE **PAGE NO.**