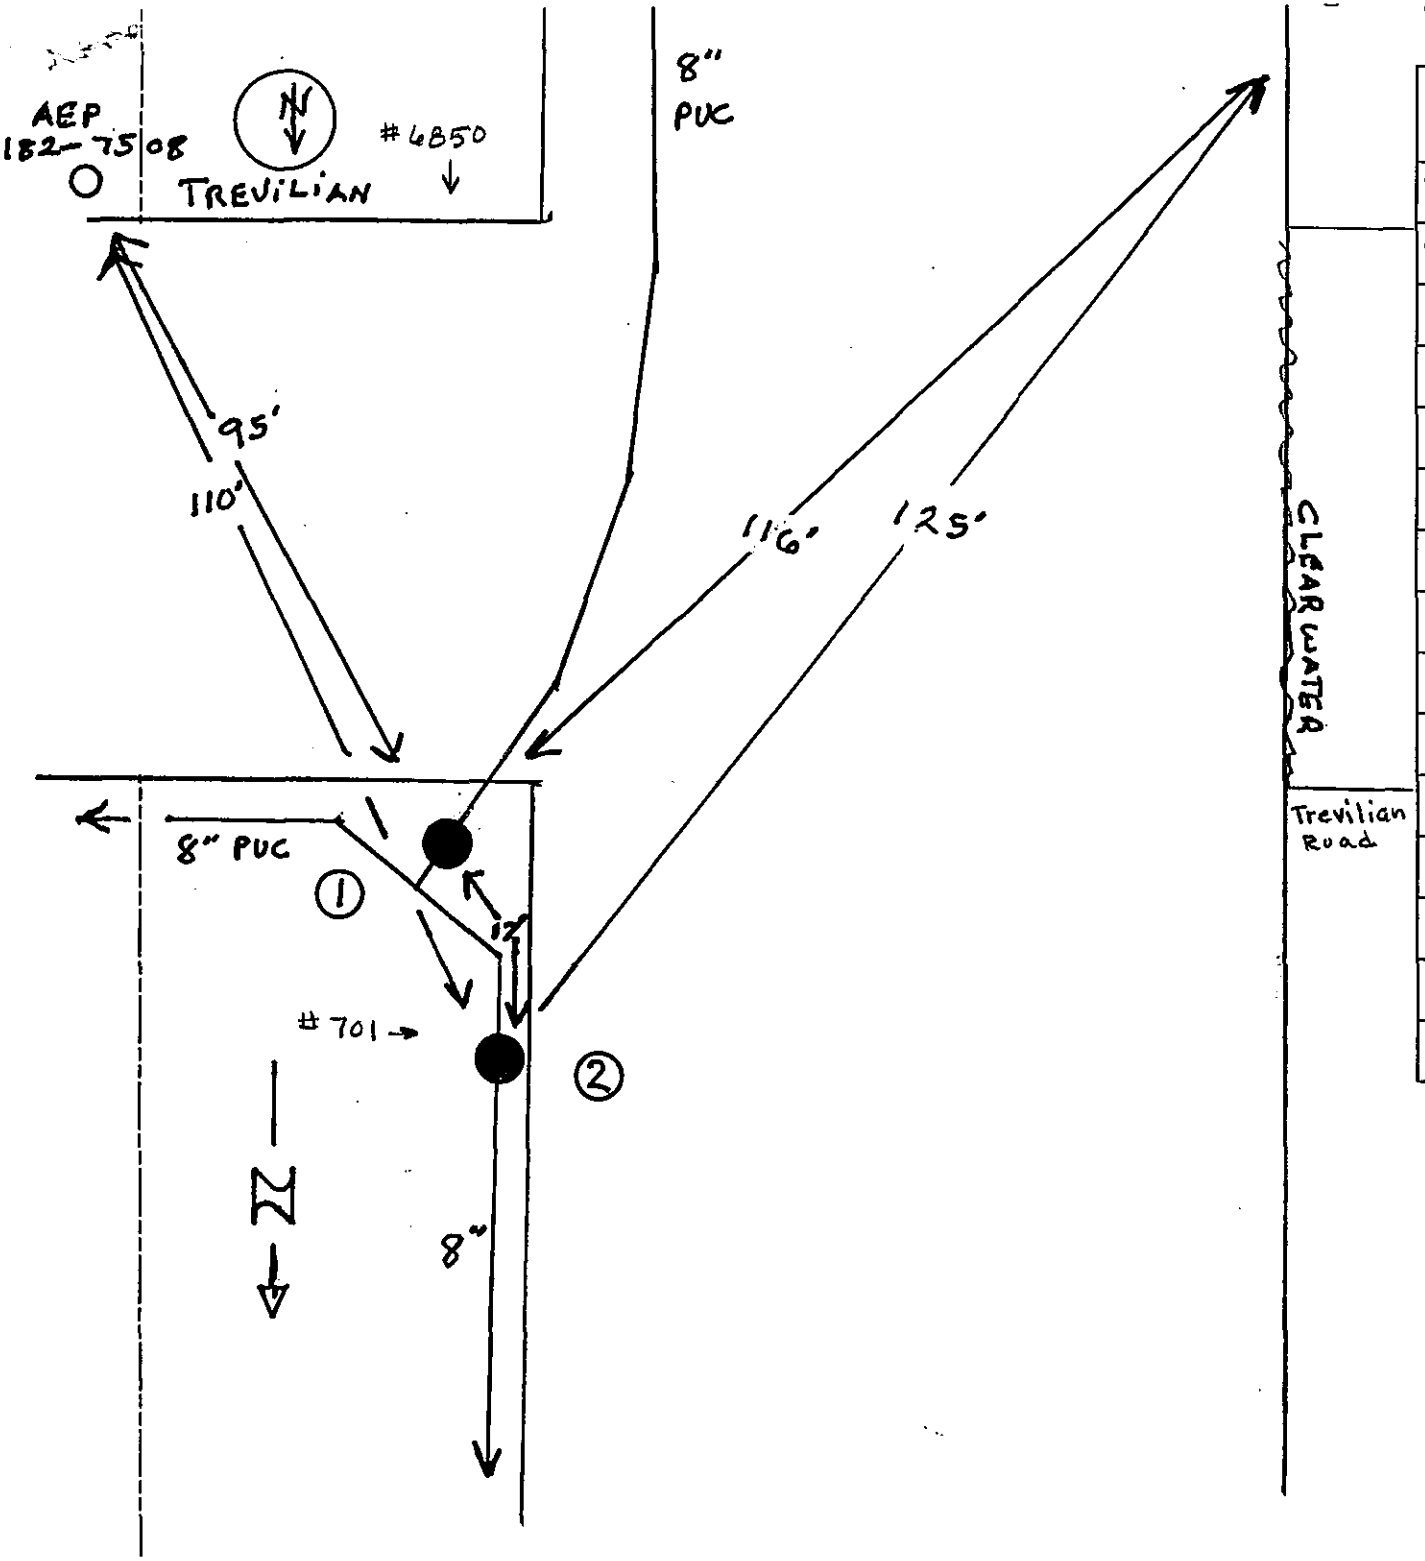

DATE	NO.	SIZE	MAKE	OPEN	TURNS
8/08	1	8"	KENNEDY	L	27
8/08	2	8"	KENNEDY	L	27

WESTERN VIRGINIA WATER AUTHORITY

VALVE DIAGRAM

TREVILIAN ROAD AND

CLEAR WATER AVE. NE

SECT. MAP

DATE 8-14-08