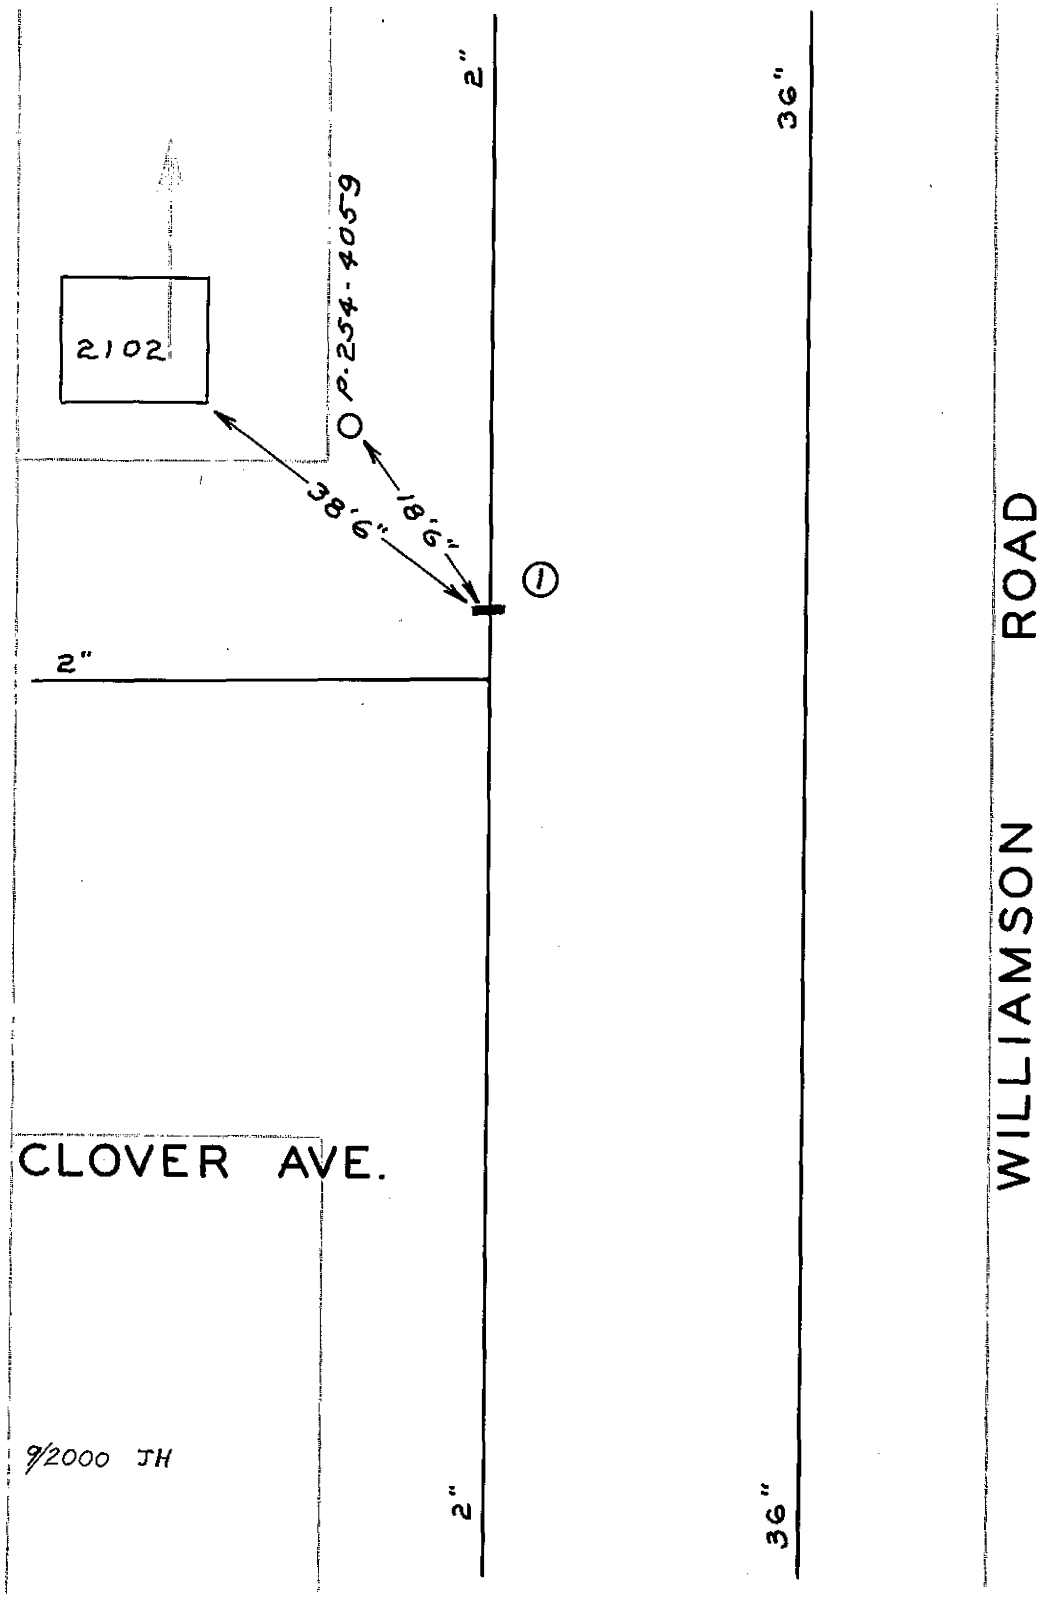

DATE	NO.	SIZE	MAKE	VOLTS	TURNS
1924	1	2"		R	8
	1	15'-S	NPL		

CITY OF ROANOKE - WATER DEPT
VALVE DIAGRAM

CLOVER AVE. &
WILLIAMSON RD.

SEC MAP 308, N. E.

DATE PAGE NO