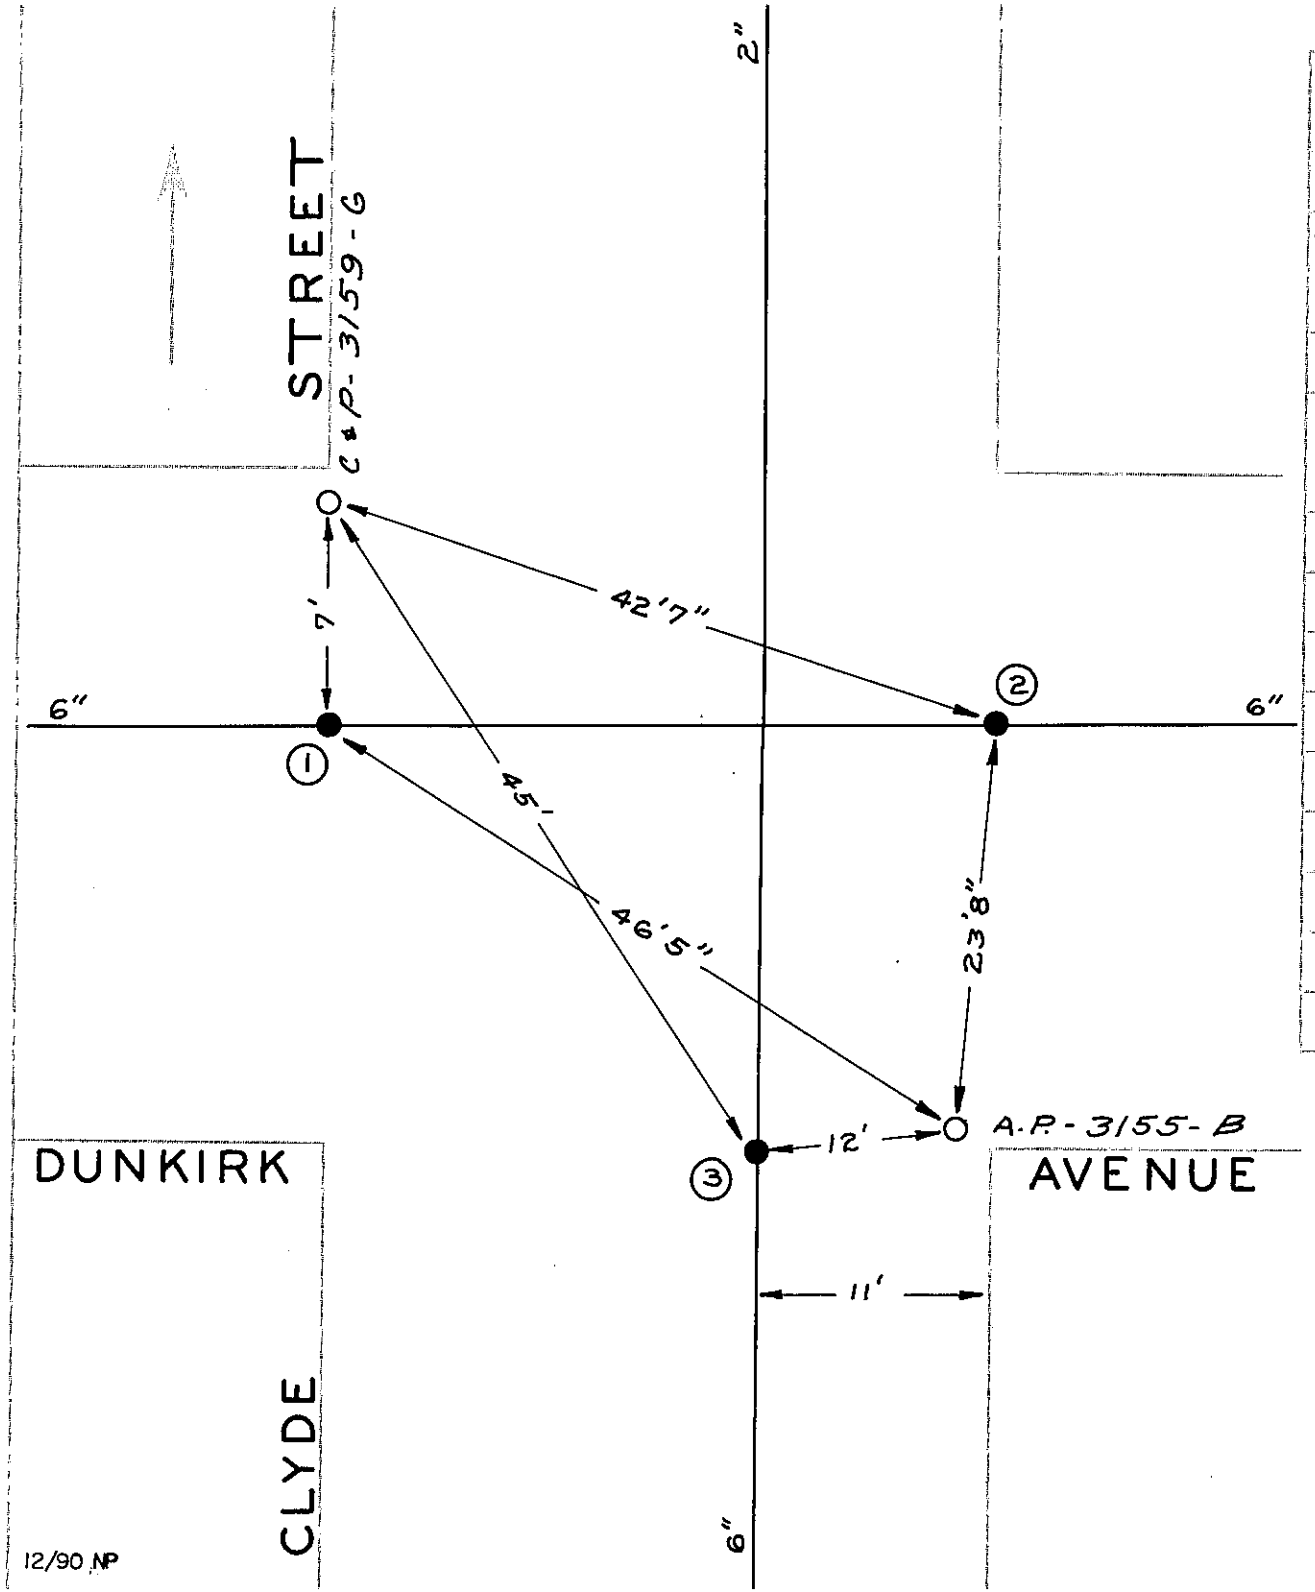

DATE	NO.	SIZE	MAKE	OPEN	TURNS
'58	1	6"	MUELLER	R	
'58	2	6"	MUELLER	R	
'59	3	6"	MUELLER	R	
	1	0	WPL		
	2	0	EPL		
	3	0	SPL		

CITY OF ROANOKE - WATER DEPT

VALVE DIAGRAM

CLYDE STREET &

DUNKIRK AVE. N. E.

SEE MAP 332

DATE PAGE NO.