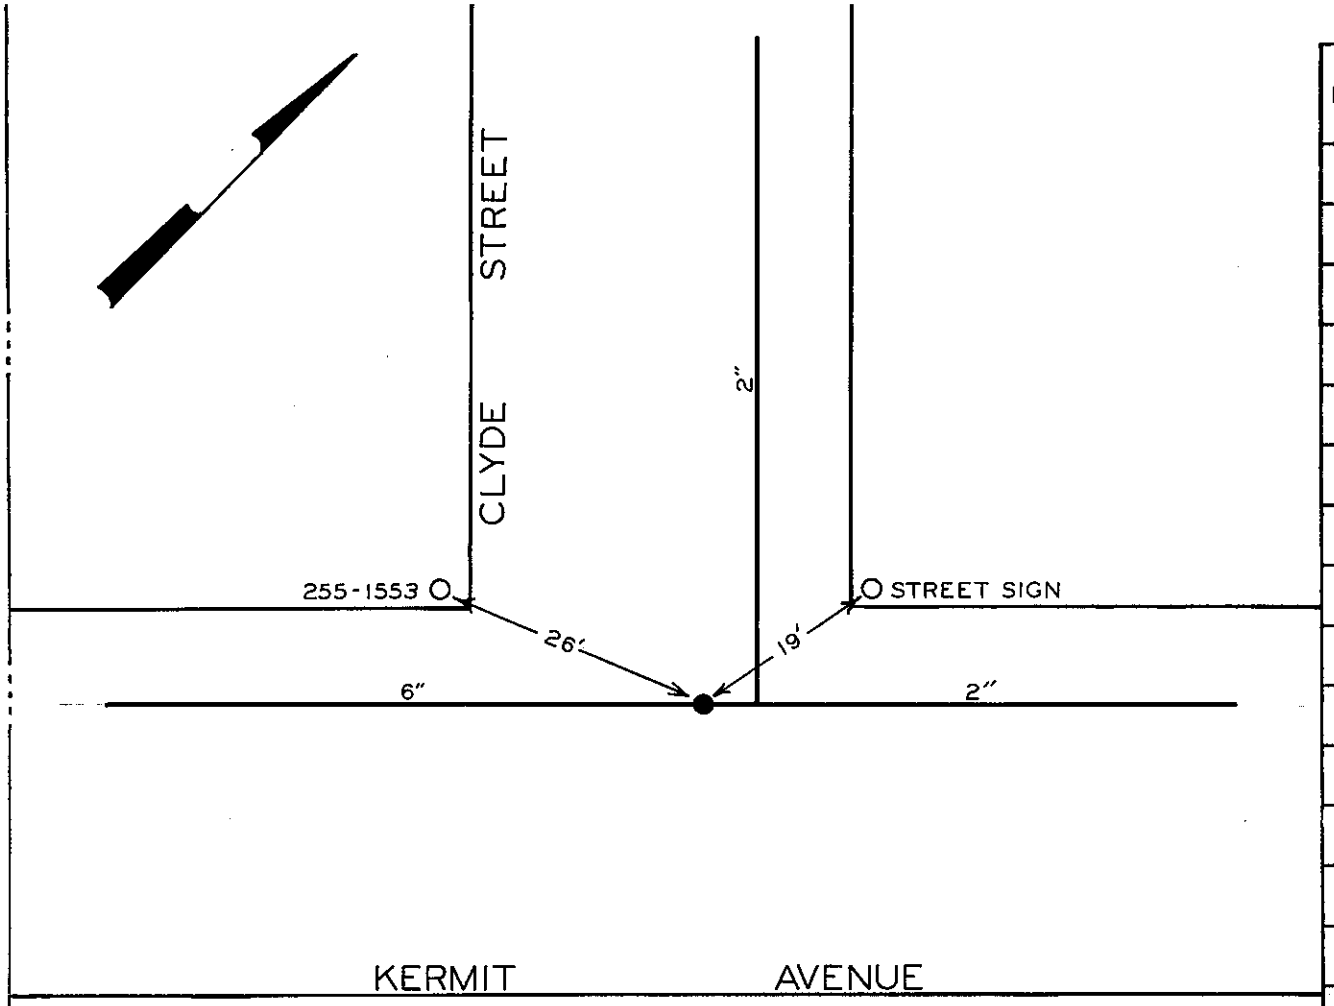

DATE	NO.	SIZE	MAKE	OPEN	TURNS
69	1	2"	DARLING	R	

CITY OF ROANOKE—WATER DEPT.

VALVE DIAGRAM

CLYDE ST. & KERMIT AVE. N.E.

SEC. MAP 332

DATE **PAGE NO.**

12/90 NP