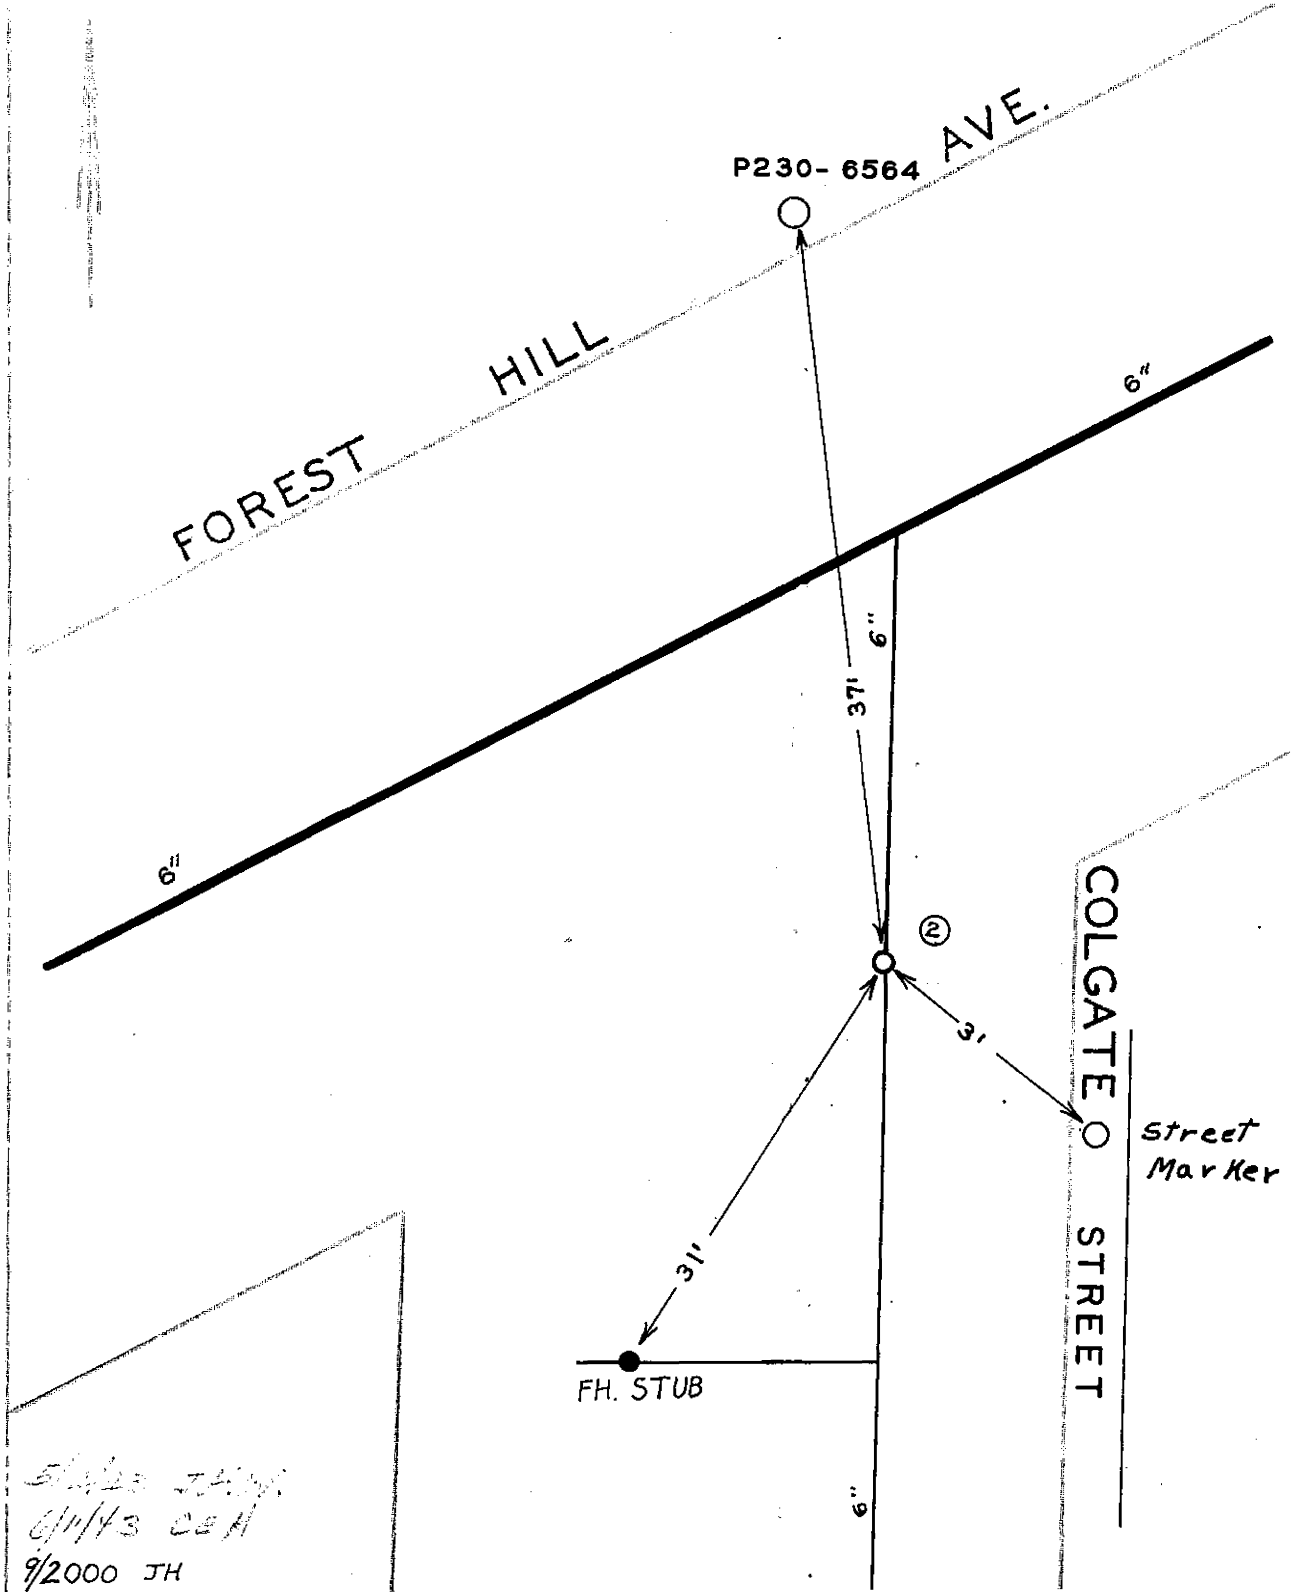

DATE	NO	SIZE	MAKE	OPEN	TYPE
11-62	2	6"	MUELLER	R	
	2	0	S.P.L.		

CITY OF ROANOKE WATER DEPT
VALVE DIAGRAM

COLGATE STREET &
FOREST HILL AVE.

SEC MAP 309, 308

DATE PAGE NO N.E. 90

Sketch JH
6/11/43 CEH
9/2000 JH