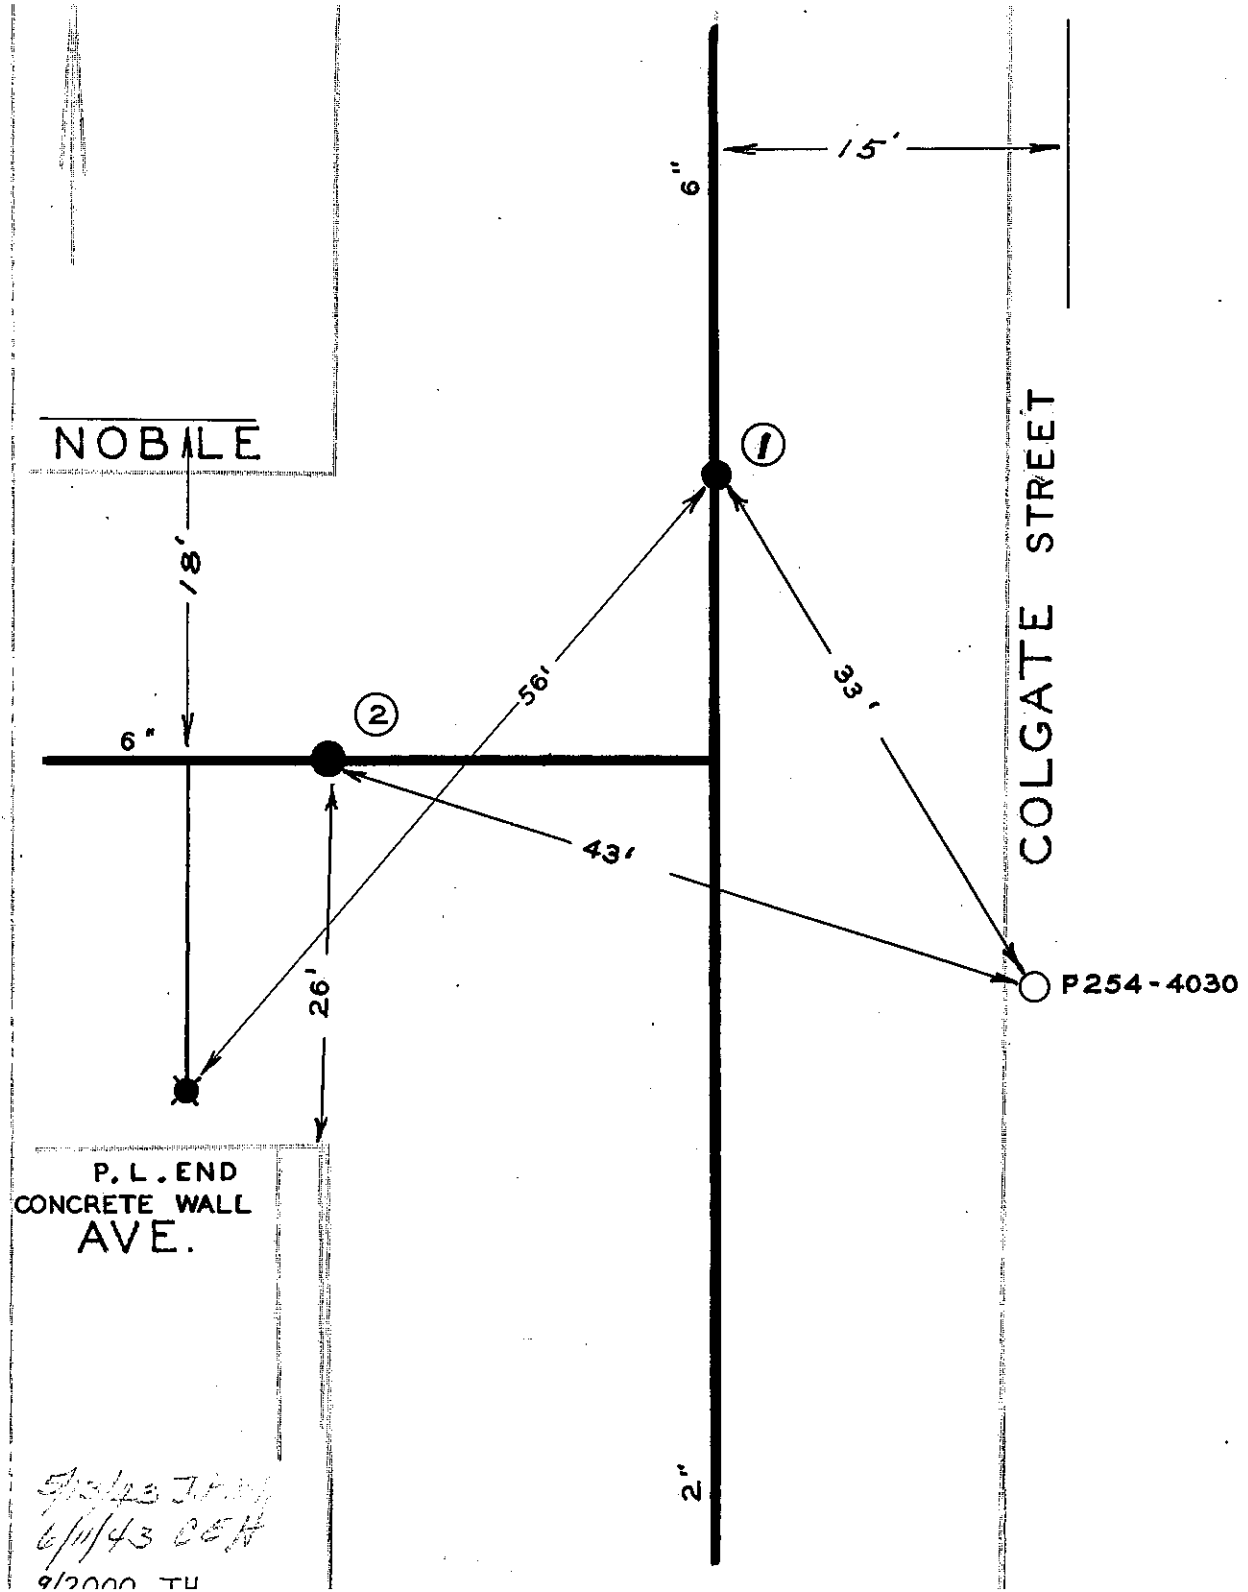

DATE	NO.	SIZE	MARKS	OPEN	TURNS
11-62	1	6"	DARLING	R	20
1926	2	6"		R	22
	1	0	NPL		
	2	0	WPL		

CITY OF ROANOKE - WATER DEPT

VALVE DIAGRAM

COLGATE STREET &

NOBLE AVENUE

SEC MAP 311 N.E.

DATE PAGE NO NE 87