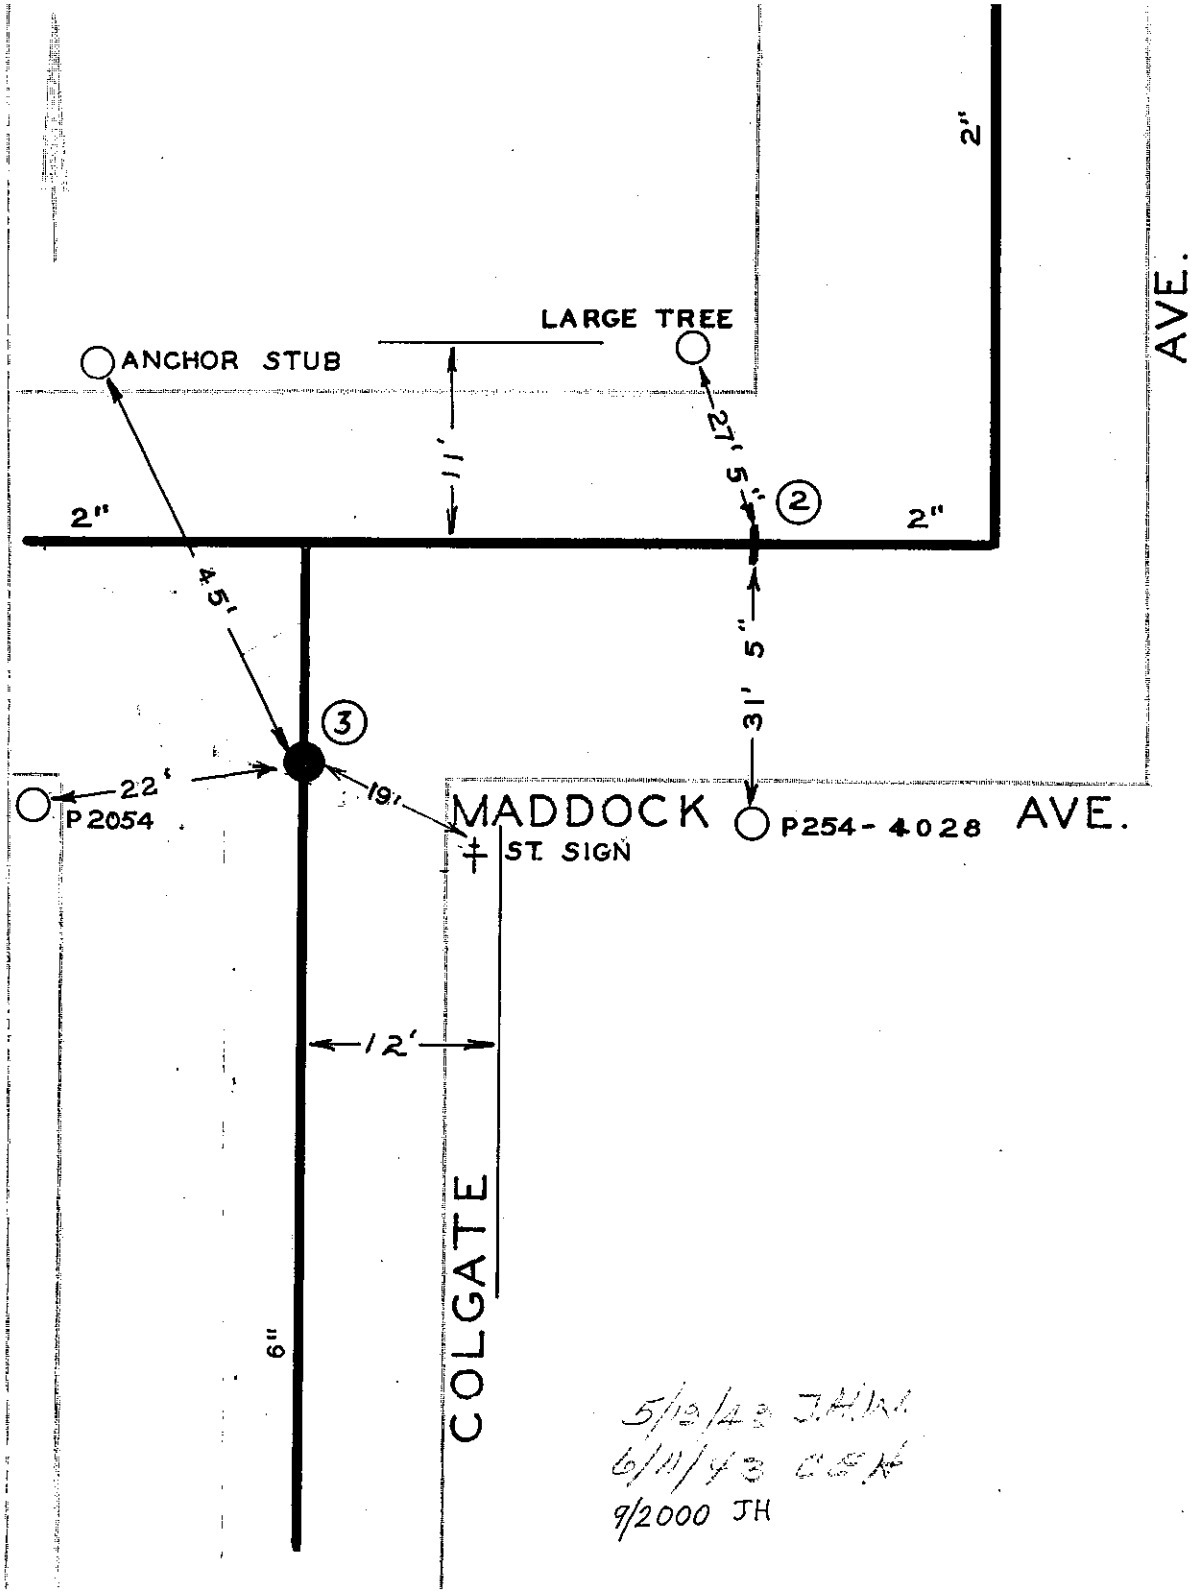

DATE	NO.	SIZE	NAME	OPEN	TURNS
1927	2	2"		R	7
8-62	3	6"	DARLING	R	20
	2	9"-E	WPL		
	3	0	SPL		

CITY OF ROANOKE - WATER DEPT
VALVE DIAGRAM

COLGATE STREET &
MADDOCK AVE. N.E.

SEC. MAP 311, 308

GRID PAGE NO NE 97