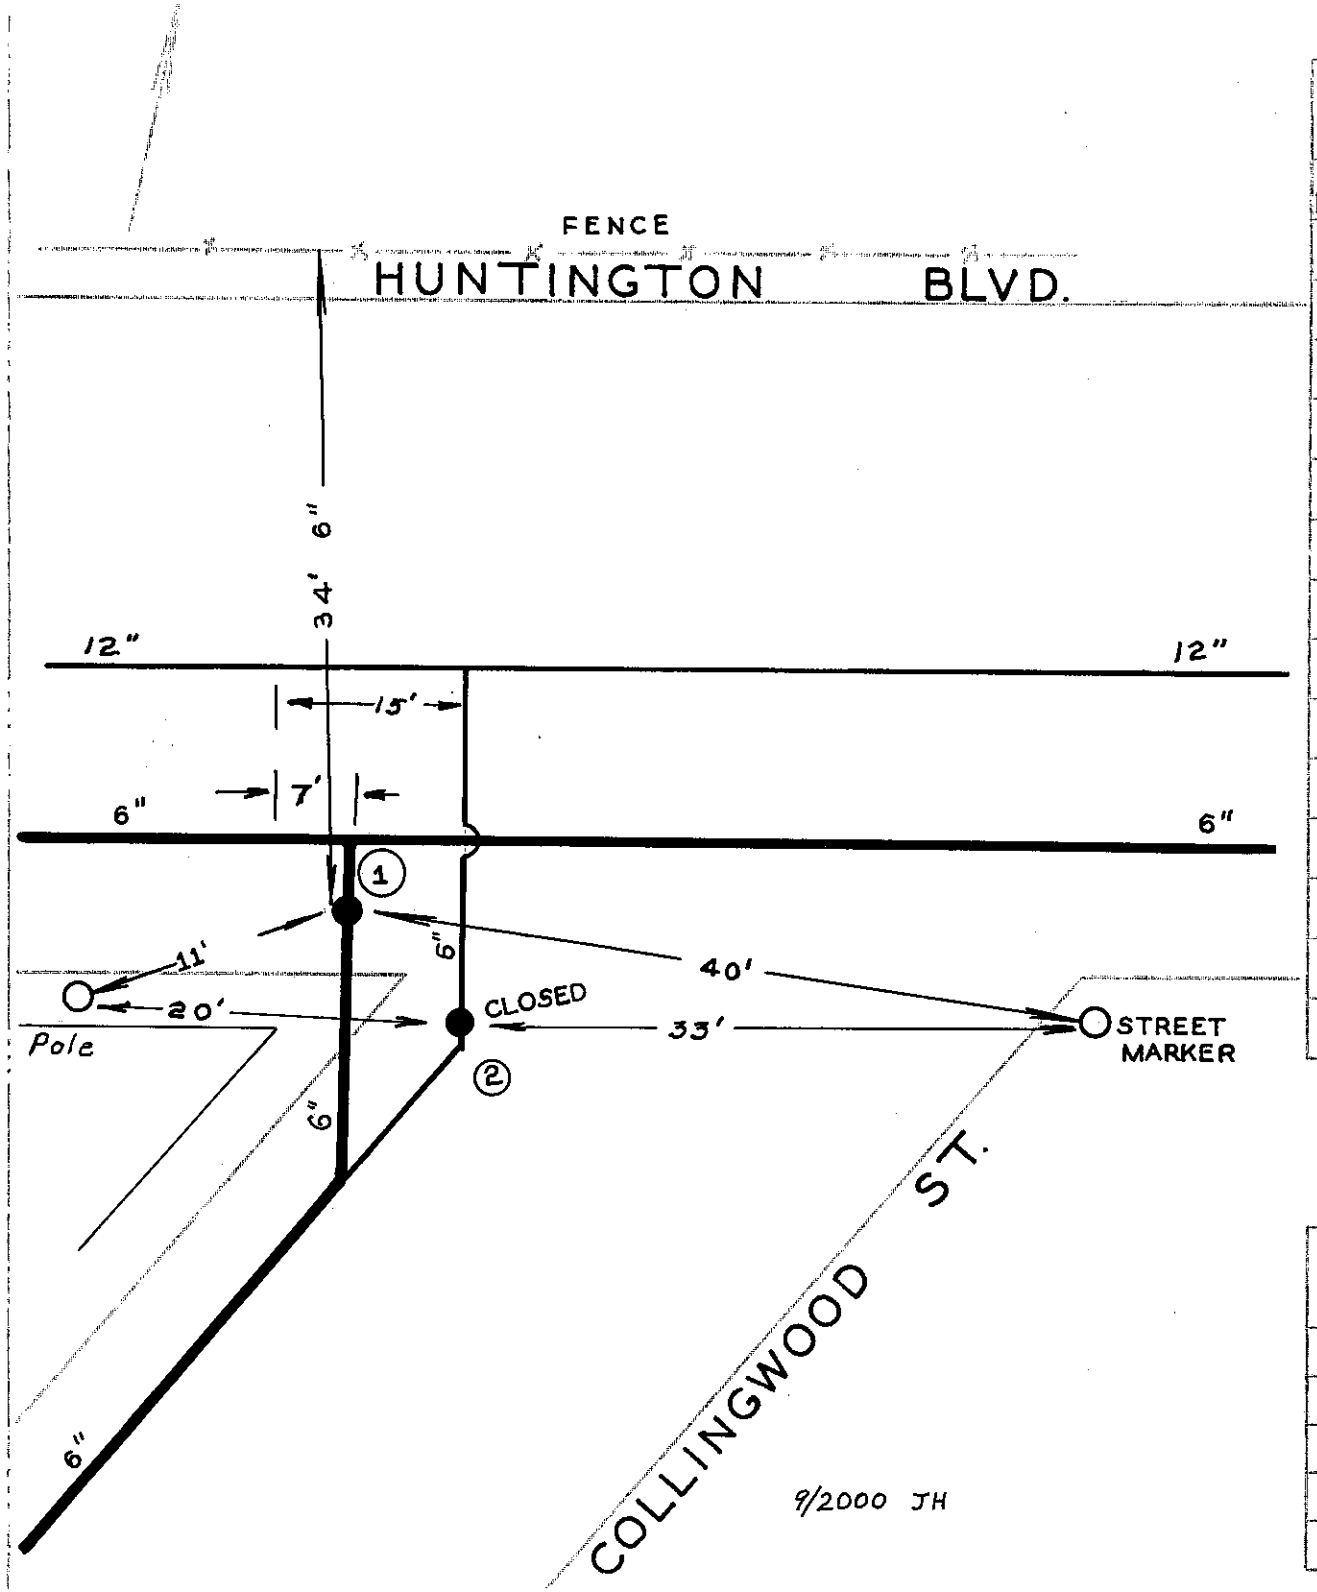

DATE	NO.	SIZE	MAKE	OPER	TURNS
WR 1951	1	6"		R	20
1953	2	6"	MUELLER	R	20
	1	9'-N	SPL		
	2	0	SPL		

CITY OF ROANOKE — WATER DEPT.

VALVE DIAGRAM

COLLINGWOOD STREET

HUNTINGTON BOULEVARD

N.E.

SEC. MAP 316, 315, 317, 318 N.E.

DATE W.R. PAGE NO NE183