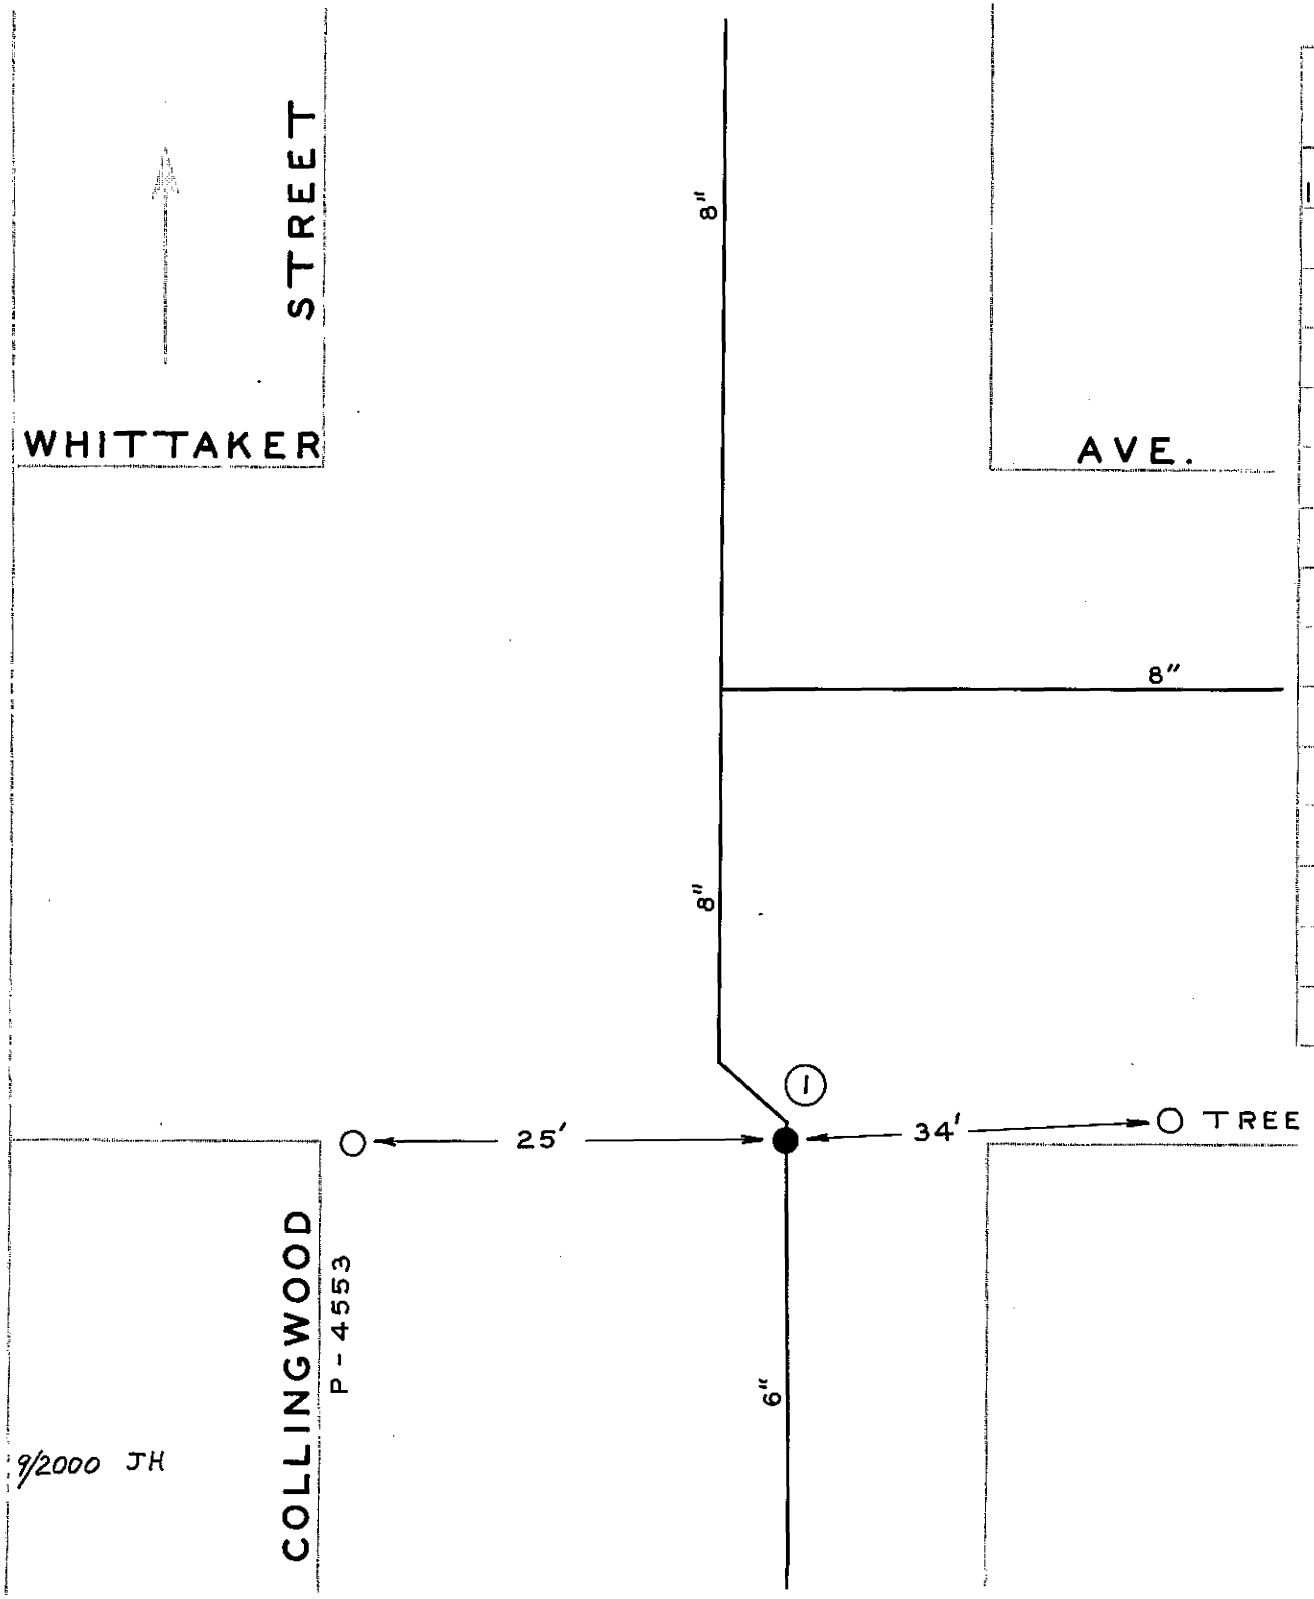

DATE	NO	SIZE	MAKE	OPEN	TURNS
1951	1	6"		R	20
	1	0	SPL		

CITY OF ROANOKE — WATER DEP'T

VALVE DIAGRAM

COLLINGWOOD ST. &
WHITTAKER AVE.

SEE MAP 316, 315, 310

DATE PAGE NO N. E.