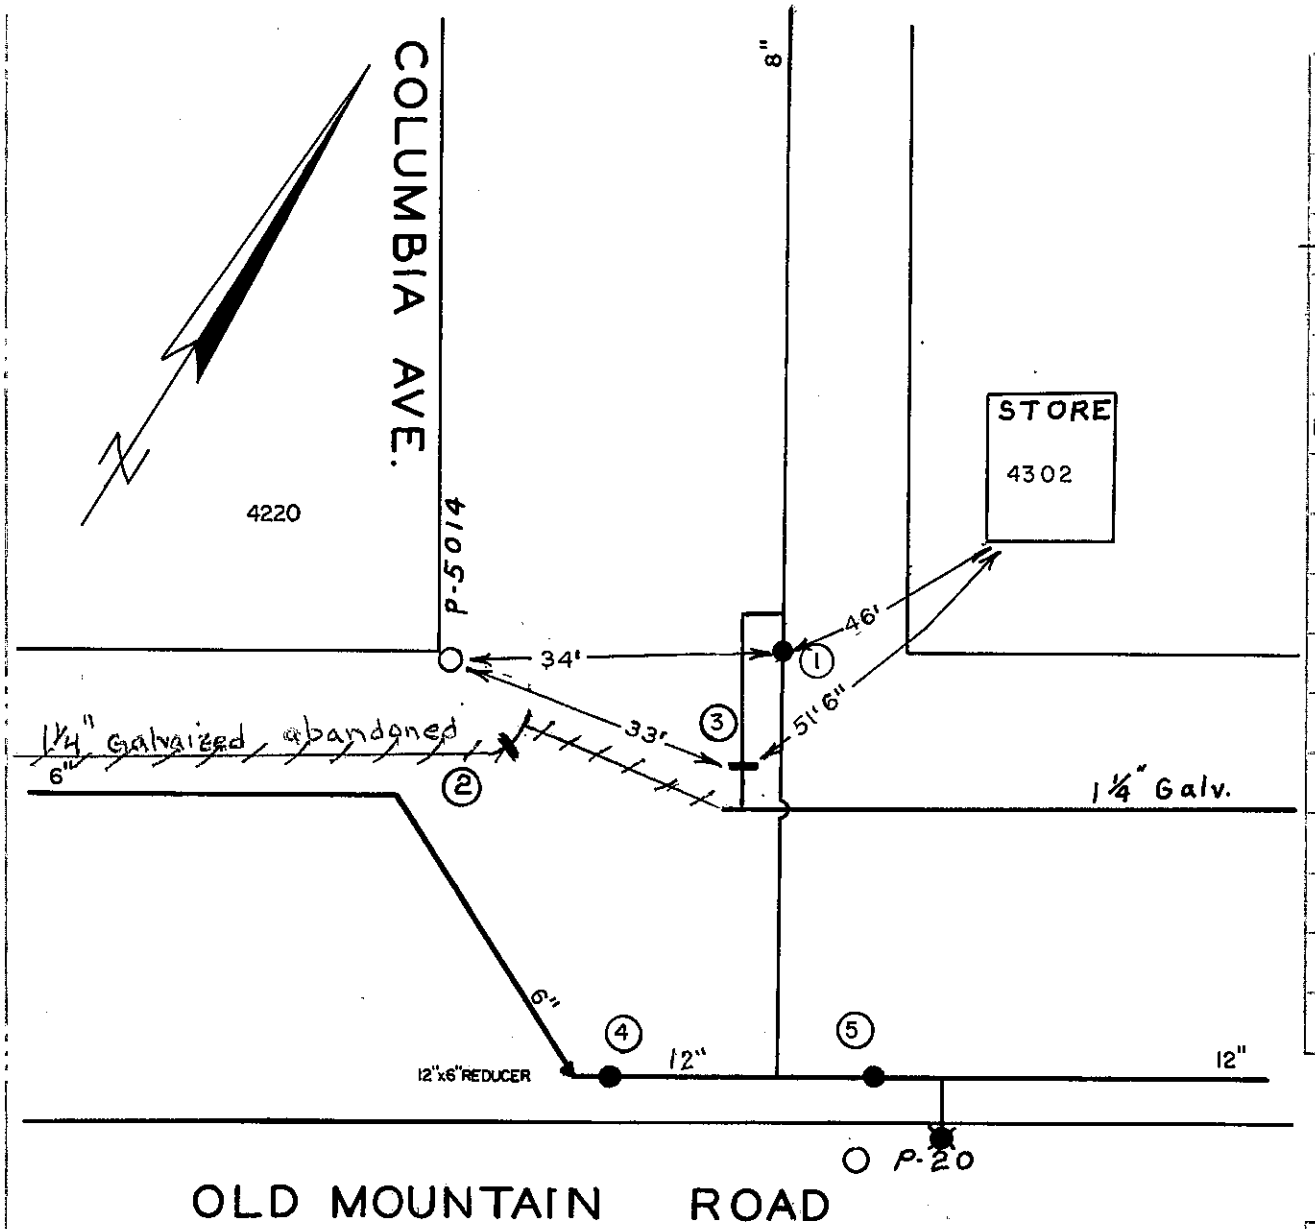

DATE	NO.	SIZE	MAKE	OPEN	TURNS
1-67	1	8"	MUELLER	R	
~~WR 1951~~	~~2~~	~~1 1/2"~~	~~MISC.~~	~~L~~	
1-67	3	2"	MISC.	L	
1977	4	12"			38
1977	5	12"			38
	1	0	W.P.L.		

CITY OF ROANOKE – WATER DEPT.

VALVE DIAGRAM

COLUMBIA AVE. & OLD MOUNTAIN ROAD N.E.

SEC. MAP 733, 736

DATE PAGE NO.

2/95 NP