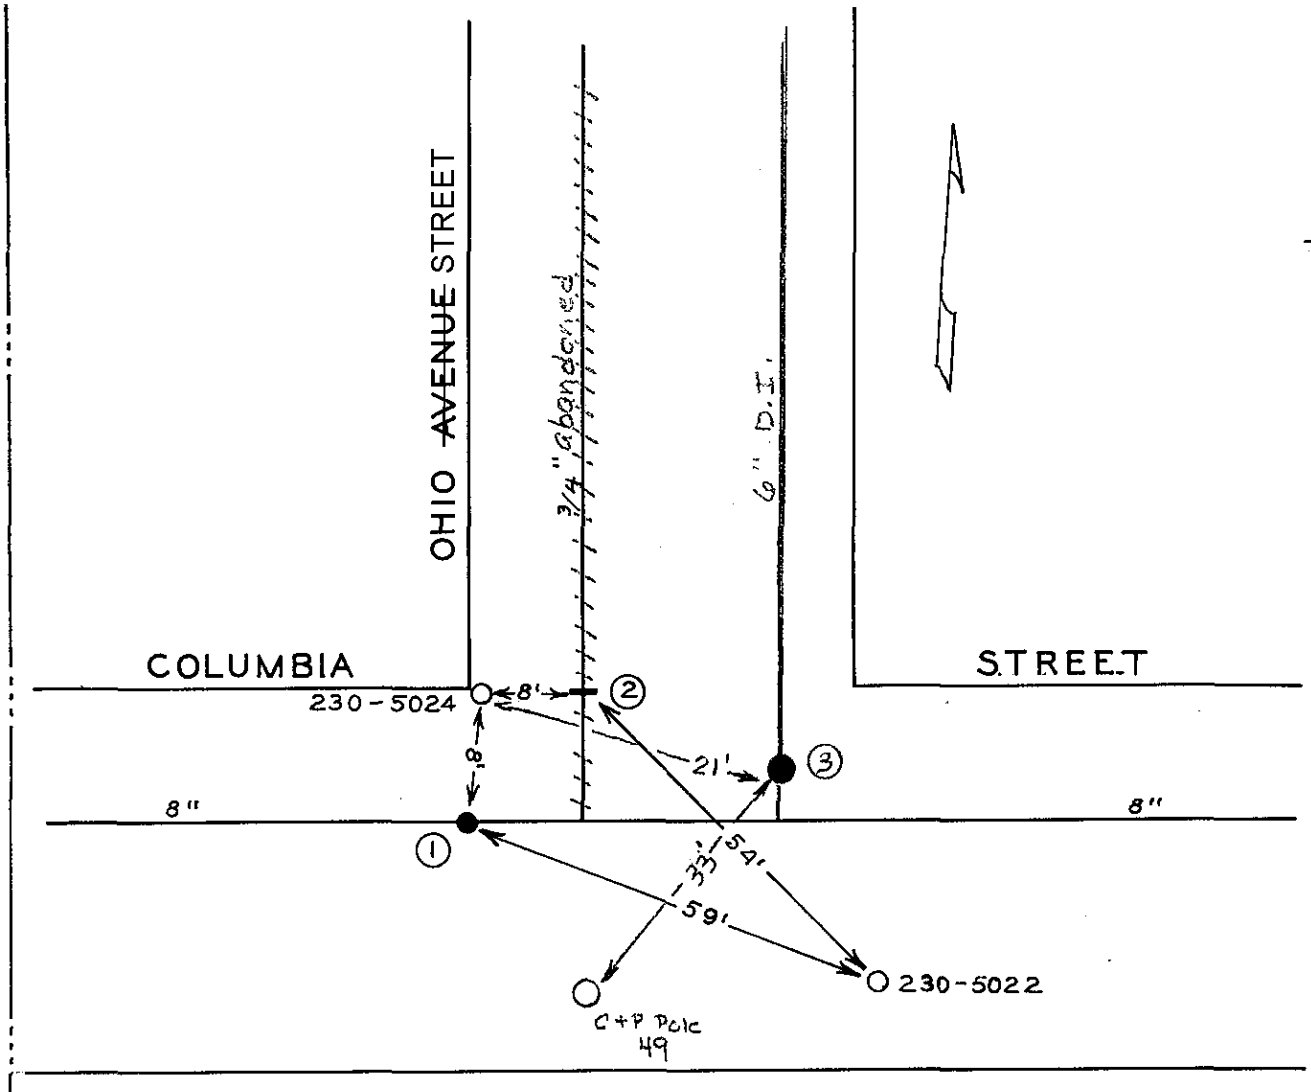

DATE	NO.	SIZE	MAKE	OPEN	TURNS
1-67	1	8"	MUELLER	R	
1-67	2	3/4"	CURB COCK		
11-94	3	6"	Mueller	R	21
	1	0	W.P.L.		

CITY OF ROANOKE—WATER DEPT.

VALVE DIAGRAM

COLUMBIA STREET &

OHIO STREET N.E.

SEC. MAP 733, 736

DATE **PAGE NO.**

2/95 NP