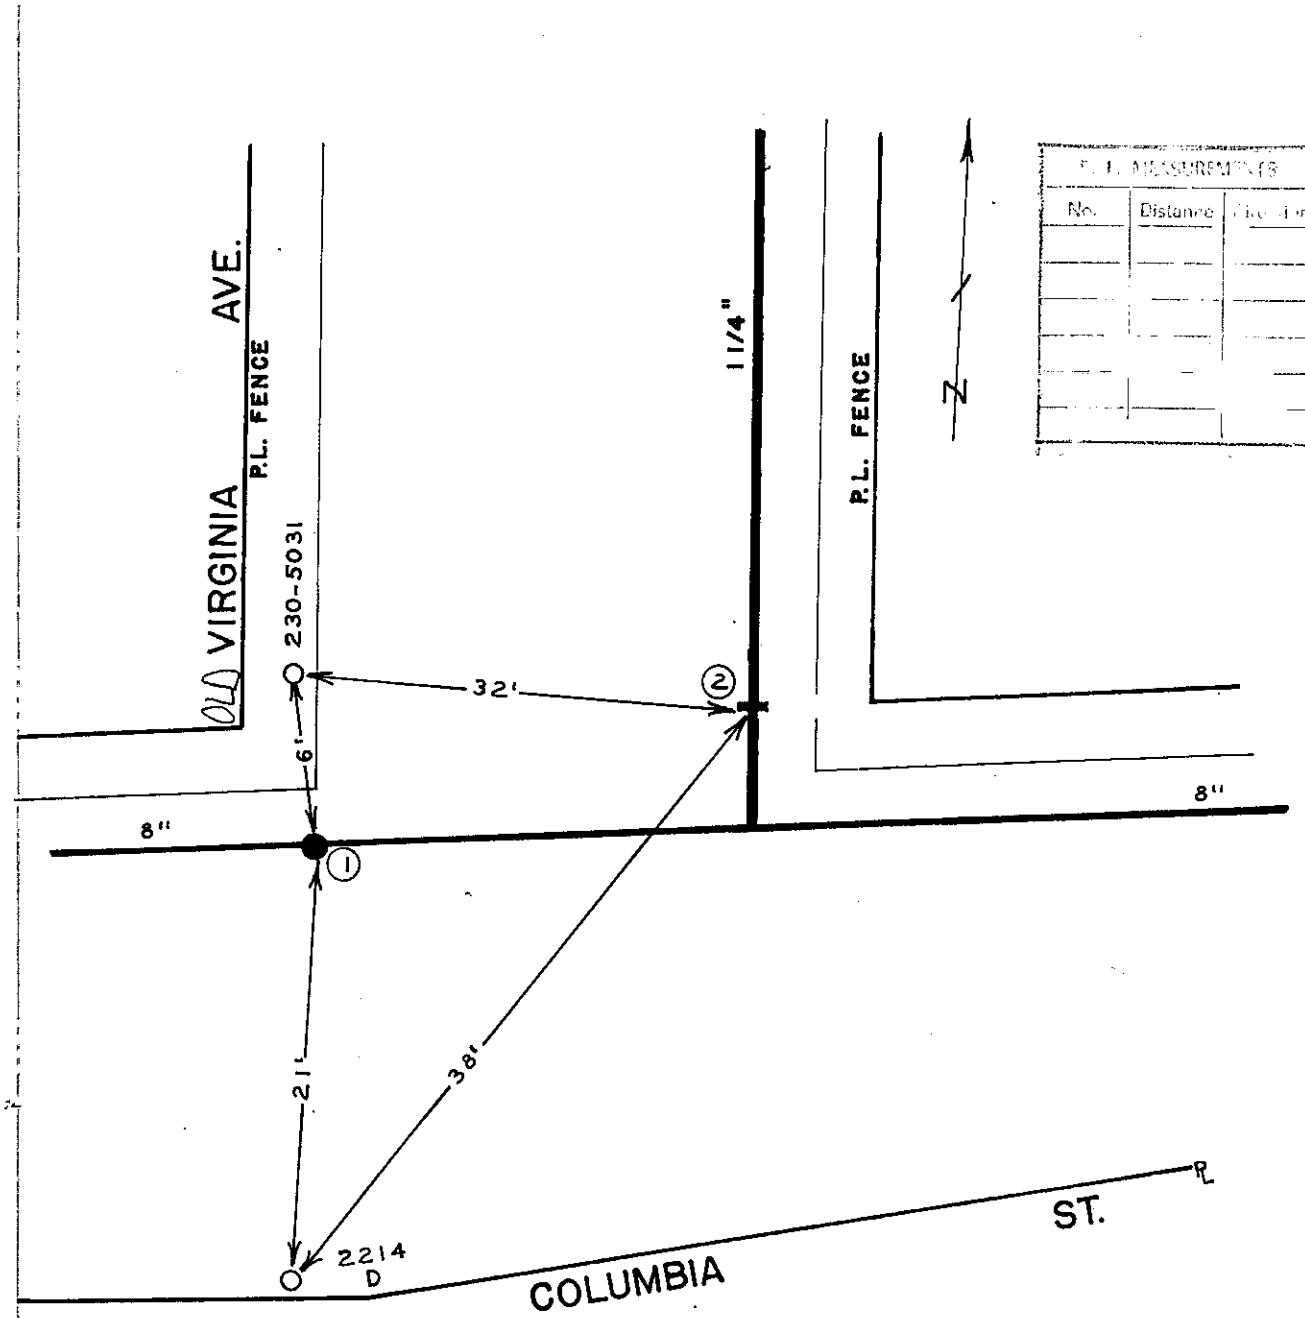

P.L. MEASUREMENTS		
No.	Distance	Direction

DATE	NO.	SIZE	MAKE	OPEN	TURNS
1-67	1	8"	MUELLER	R	
1-67	2	2"	MISC.	L	
	1	0	W.P.L.		

CITY OF ROANOKE—WATER DEPT.

VALVE DIAGRAM

COLUMBIA STREET &

Old VIRGINIA AVE. N.E.

SEC. MAP 328

DATE PAGE NO.

2/95 NP