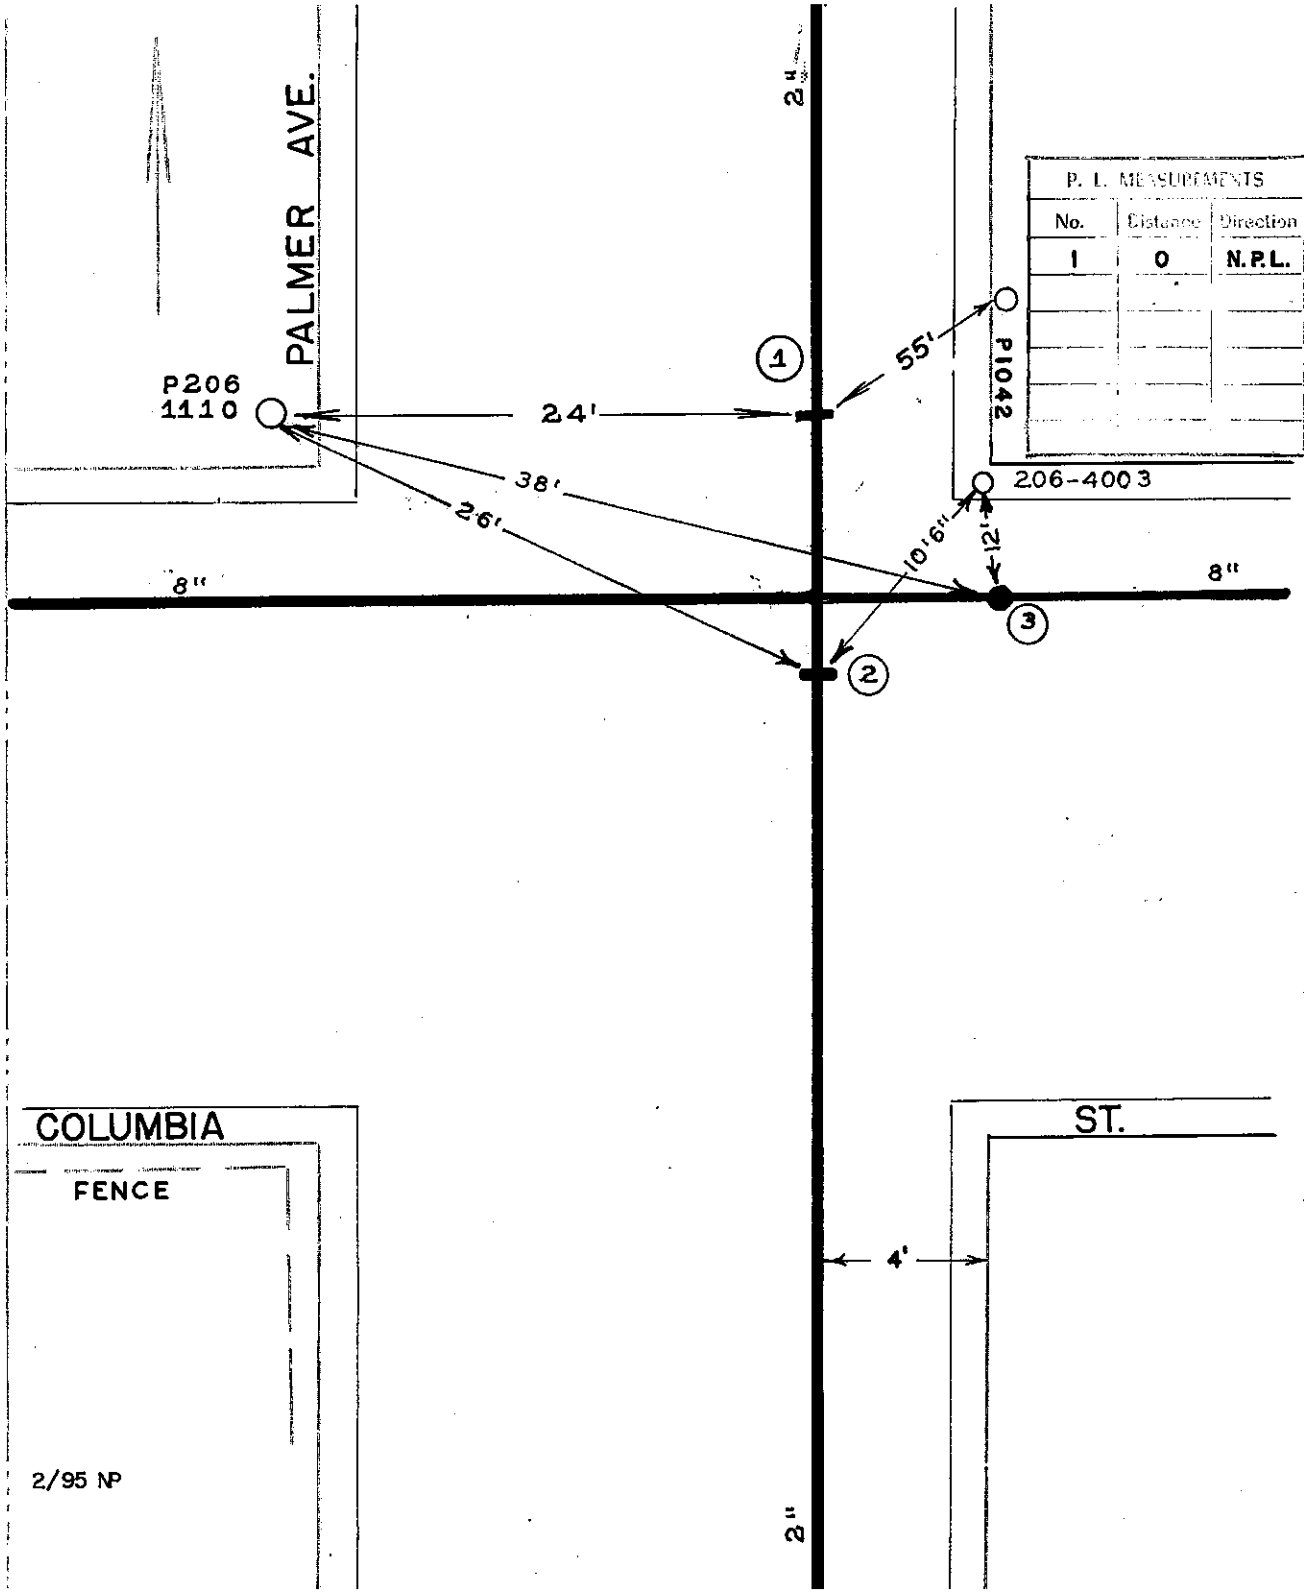

P. L. MEASUREMENTS		
No.	Distance	Direction
1	0	N.P.L.

DATE	NO.	SIZE	MAKE	OPEN	TURNS
WR 1951	1	2"			
1-67	2	2"	MISC.	L	
1-67	3	8"	MUELLER	R	
	3	0	E.P.L.		

CITY OF ROANOKE—WATER DEPT.

VALVE DIAGRAM

COLUMBIA STREET &

PALMER AVE. N.E.

SEC. MAP 328

DATE PAGE NO.