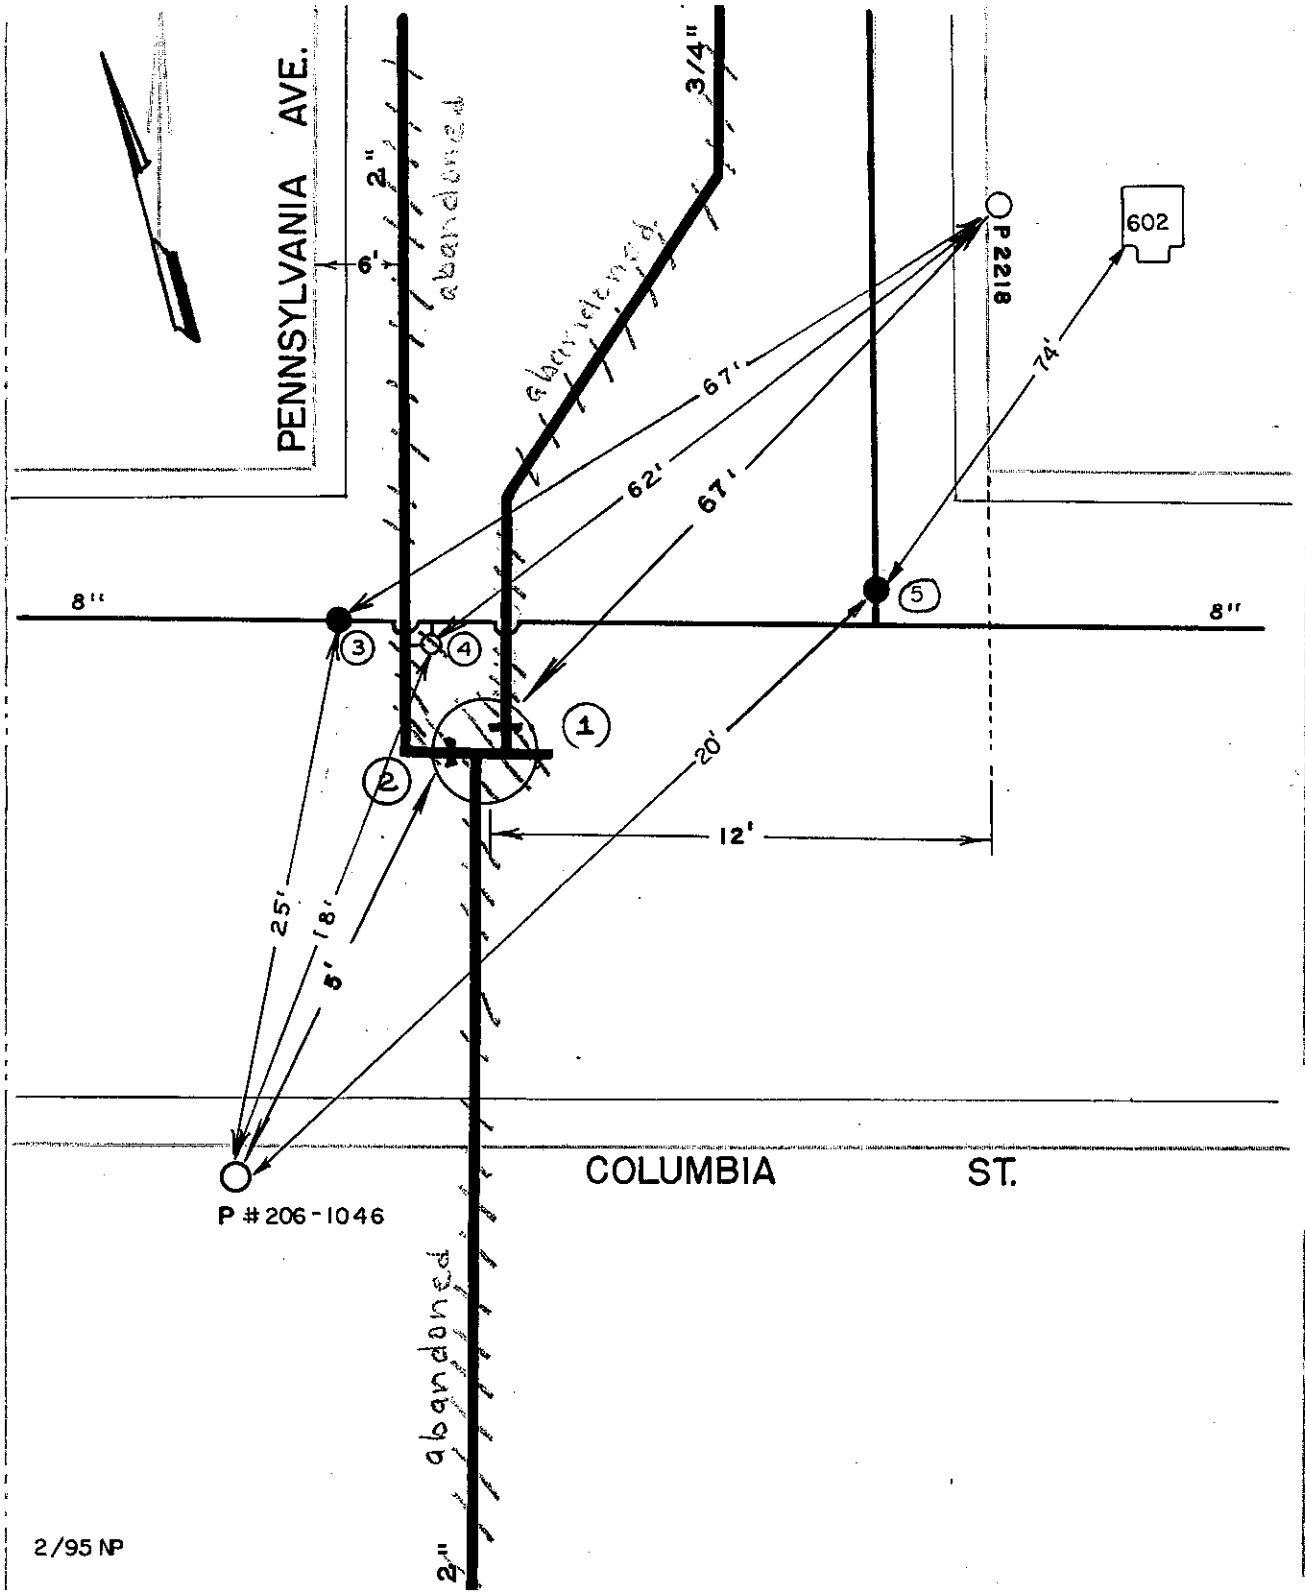

DATE	NO.	SIZE	MAKE	OPEN	TURNS
WR 1951	1	1"			
WR 1951	2	2"			
1-67	3	8"	MUELLER	R	
1-67	4	2"	MISC.	L	
6-79	5	8"	MUELLER	R	

CITY OF ROANOKE — WATER DEPT.

VALVE DIAGRAM

COLUMBIA STREET &

PENNSYLVANIA AVE. N.E.

SEC. MAP 328, 733, 736

DATE PAGE NO.

2/95 NP