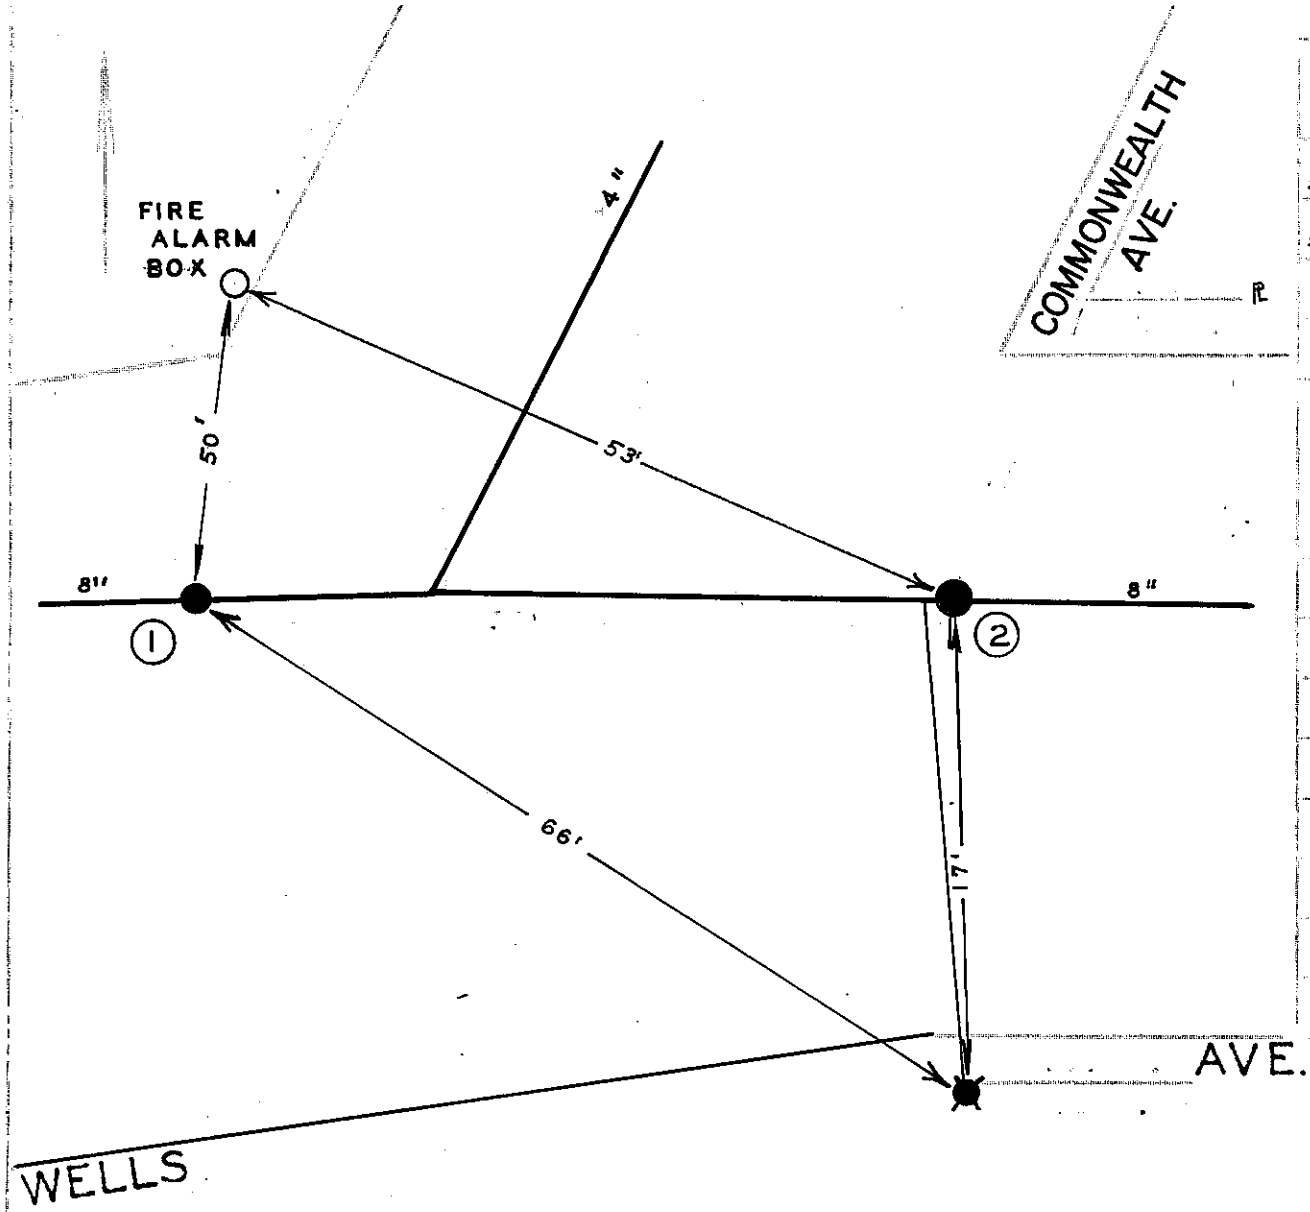

DATE	NO	SIZE	MAKE	OPEN	TURNS
5-67	1	8	MUELLER	R	
5-67	2	8	MUELLER	R.	
	1	0	WPL		
	2	0	EPL		

10/27/42 J.H.N
12-11-42 O.E.H
3/91 NP
8/2000 JH

CITY OF ROANOKE WATER DEPT
VALVE DIAGRAM

COMMONWEALTH AVE. & WELLS AVE.

SEC MAP 301

DATE PAGE NO. NE 4