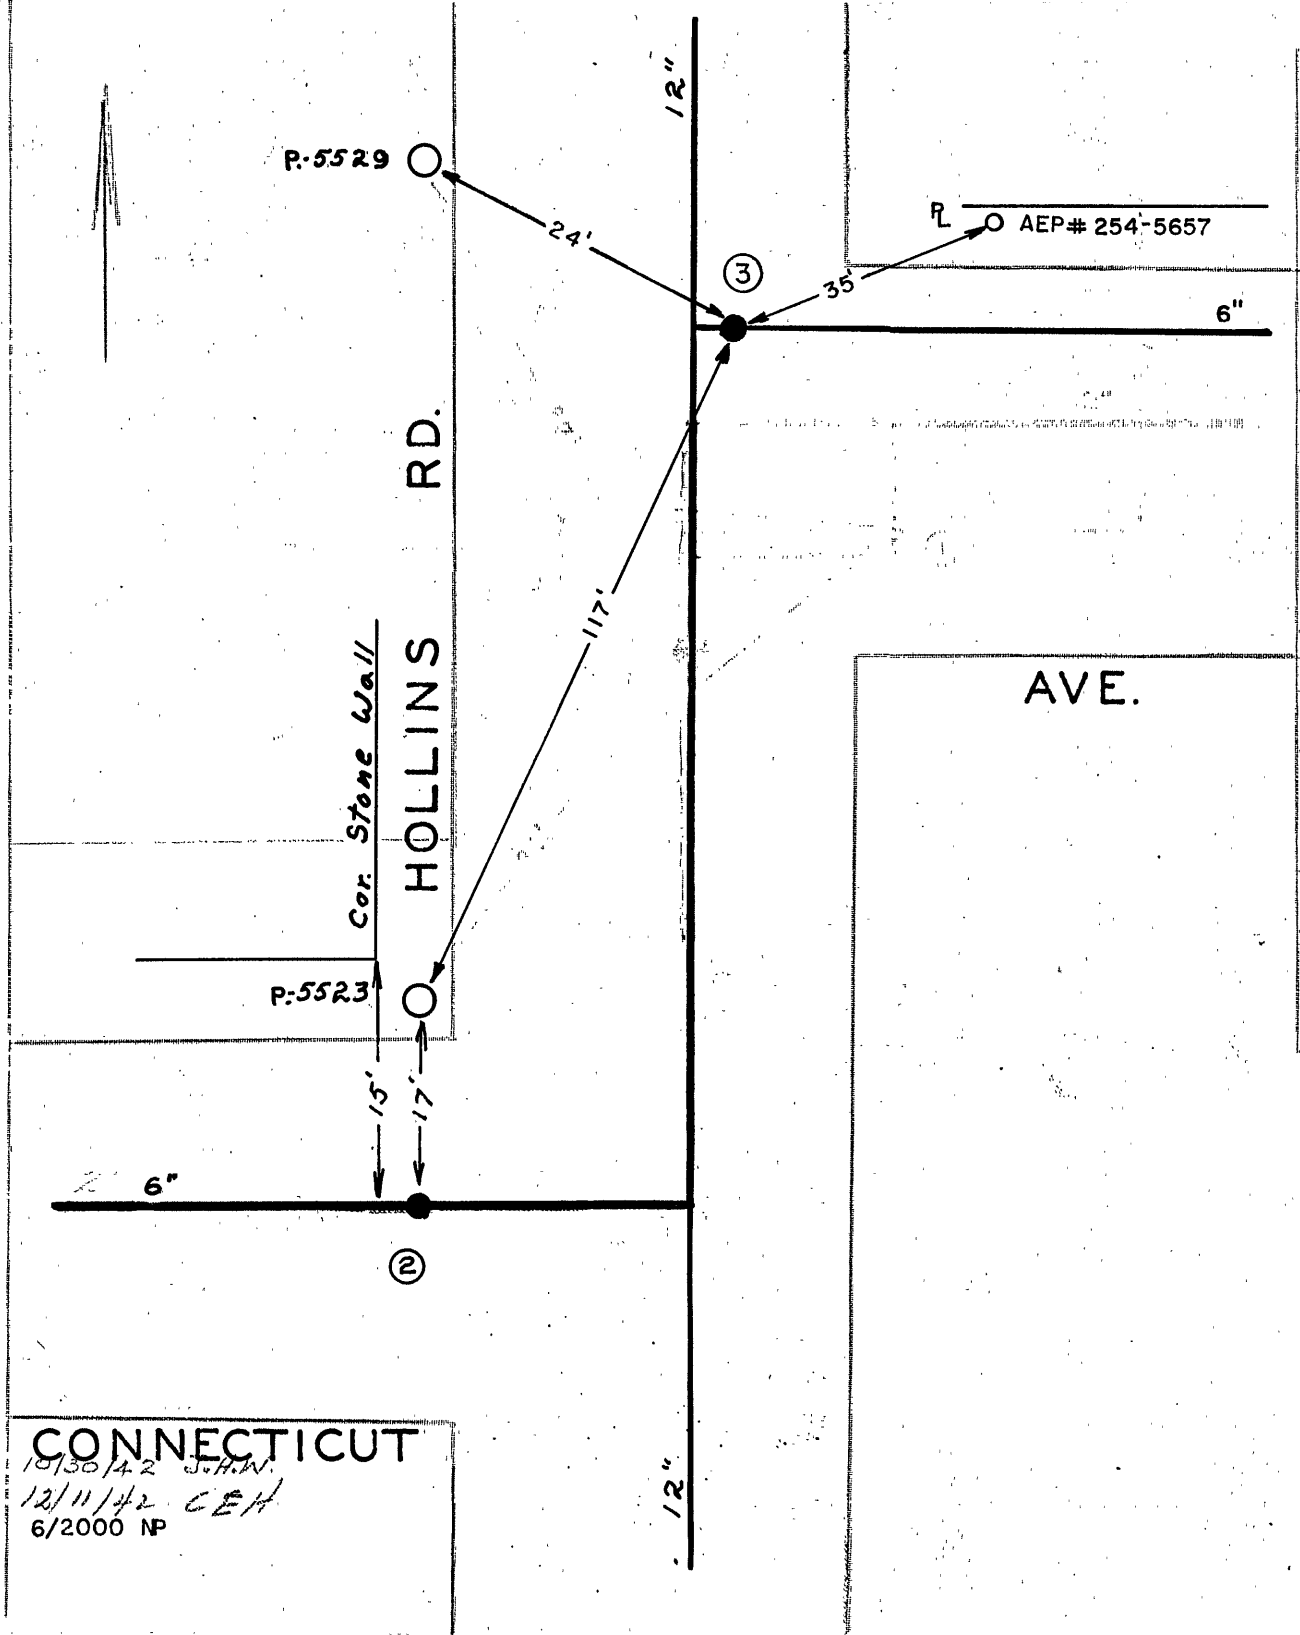

DATE	NO.	SIZE	MAKE	OPEN	TURNS
1954	2	6"	MUELLER	R	20
2000	3	6"	MUELLER	R	21
	2	0	WPL		

CITY OF ROANOKE—WATER DEPT
VALVE DIAGRAM
CONNECTICUT AVE. &
HOLLINS RD. N. E.

SEC. MAP 304, 306
DATE PAGE NO. NE 71