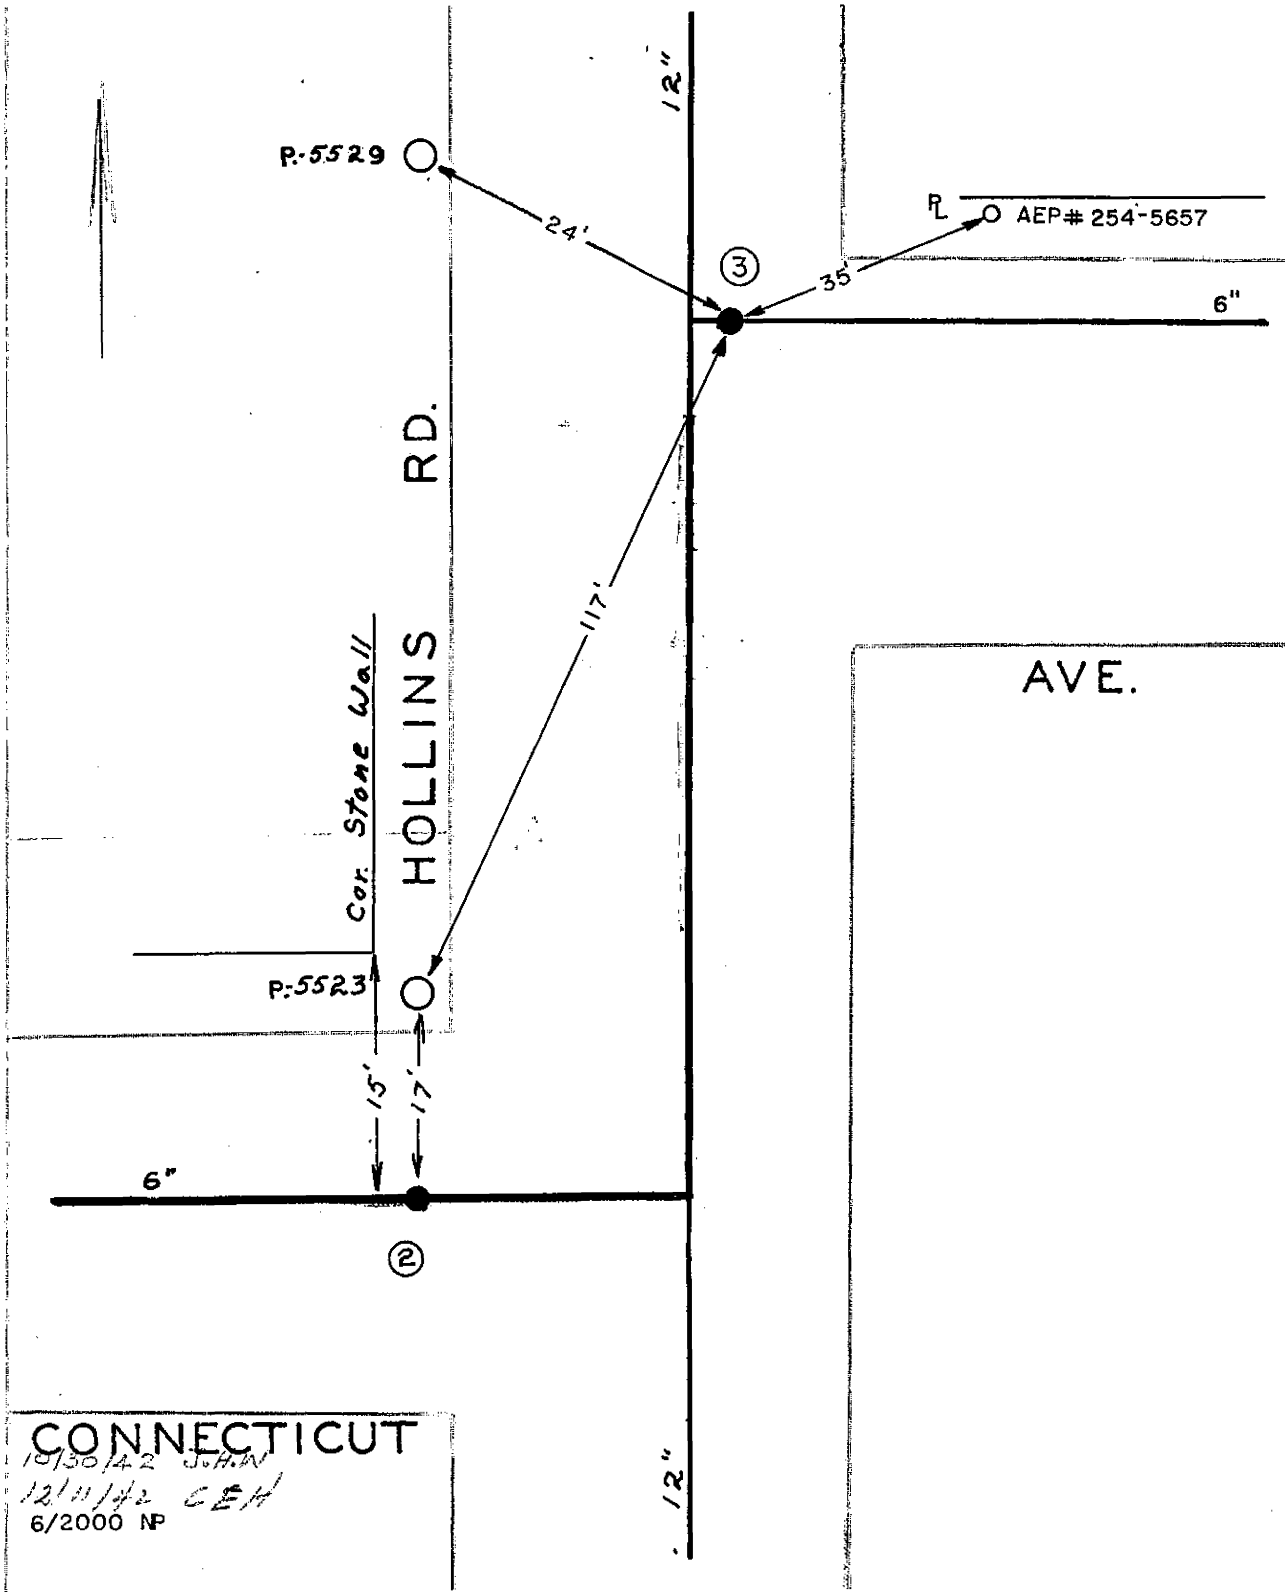

DATE	NO	SIZE	MAKE	OPEN	TURNS
1954	2	6"	MUELLER	R	20
2000	3	6"	MUELLER	R	21
	2	0	WPL		

CONNECTICUT
10/30/42 JOHN
12/11/42 CEH
6/2000 NP

CITY OF ROANOKE - WATER DEPT
VALVE DIAGRAM
CONNECTICUT AVE. &
HOLLINS RD. N. E.

SEC MAP 304, 306
DATE PAGE NO NE 71