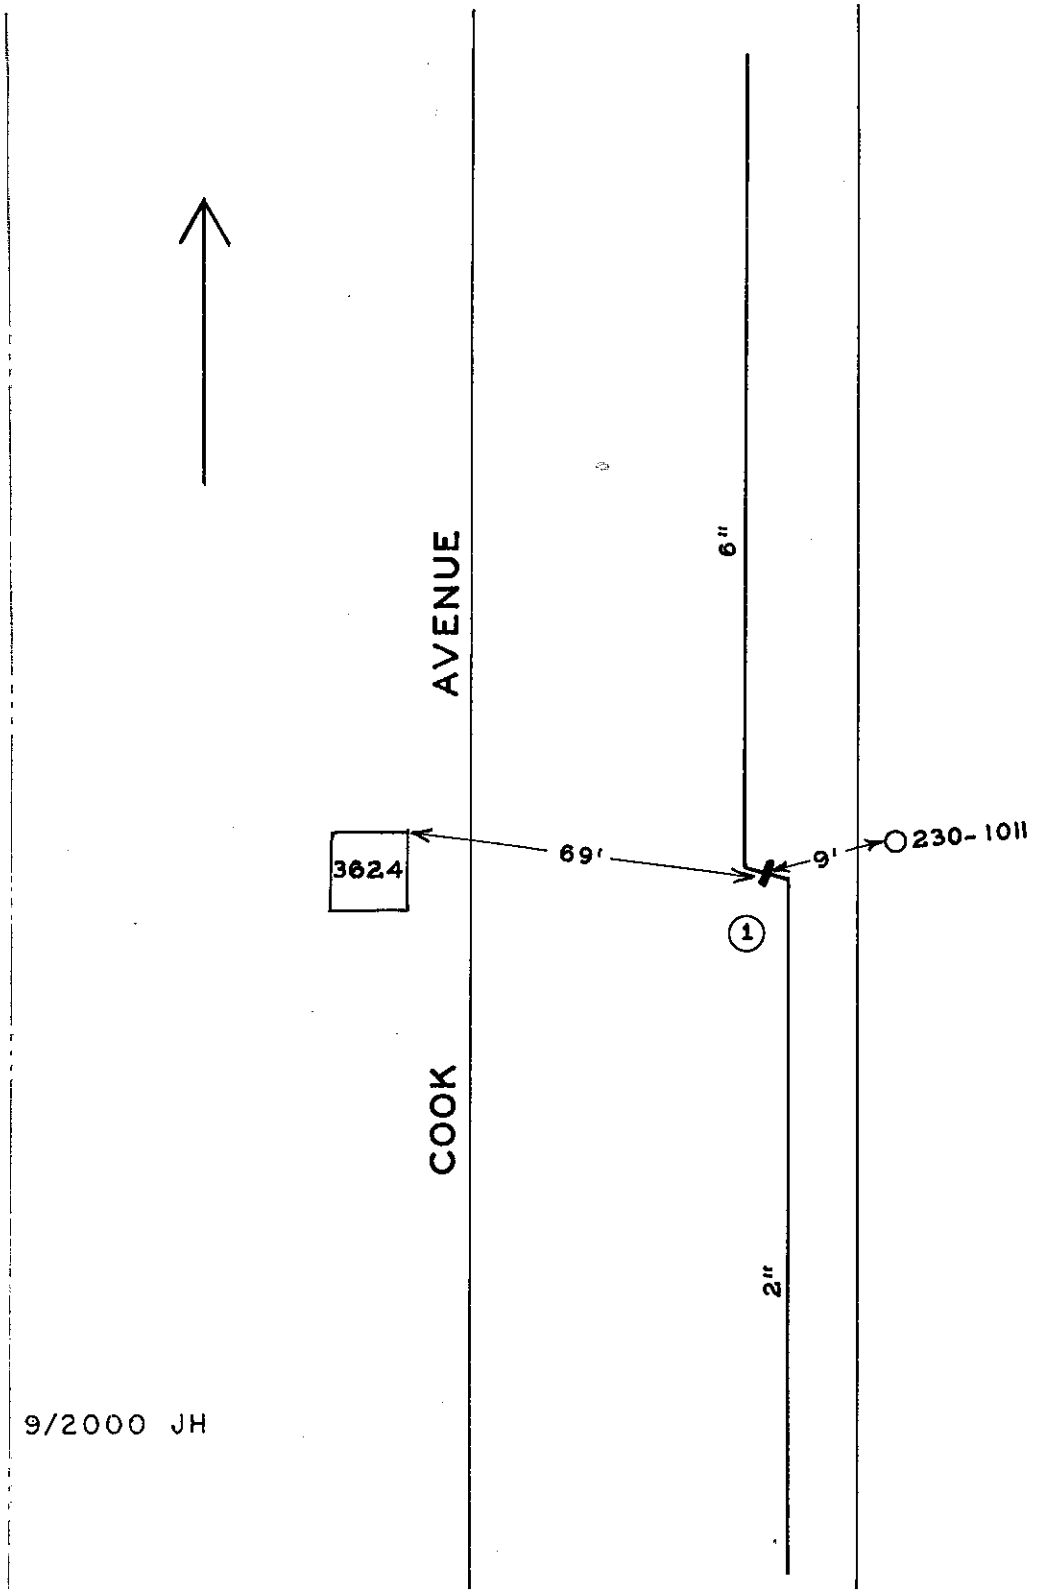

9/2000 JH

DATE	NO.	SIZE	MAKE	OPEN	TURNS
4-60	1	2"	MISC.	L	


VALVE DIAGRAM

3624 - COOK AVENUE

SEC. MAP 317,209 N.E.

DATE PAGE NO.