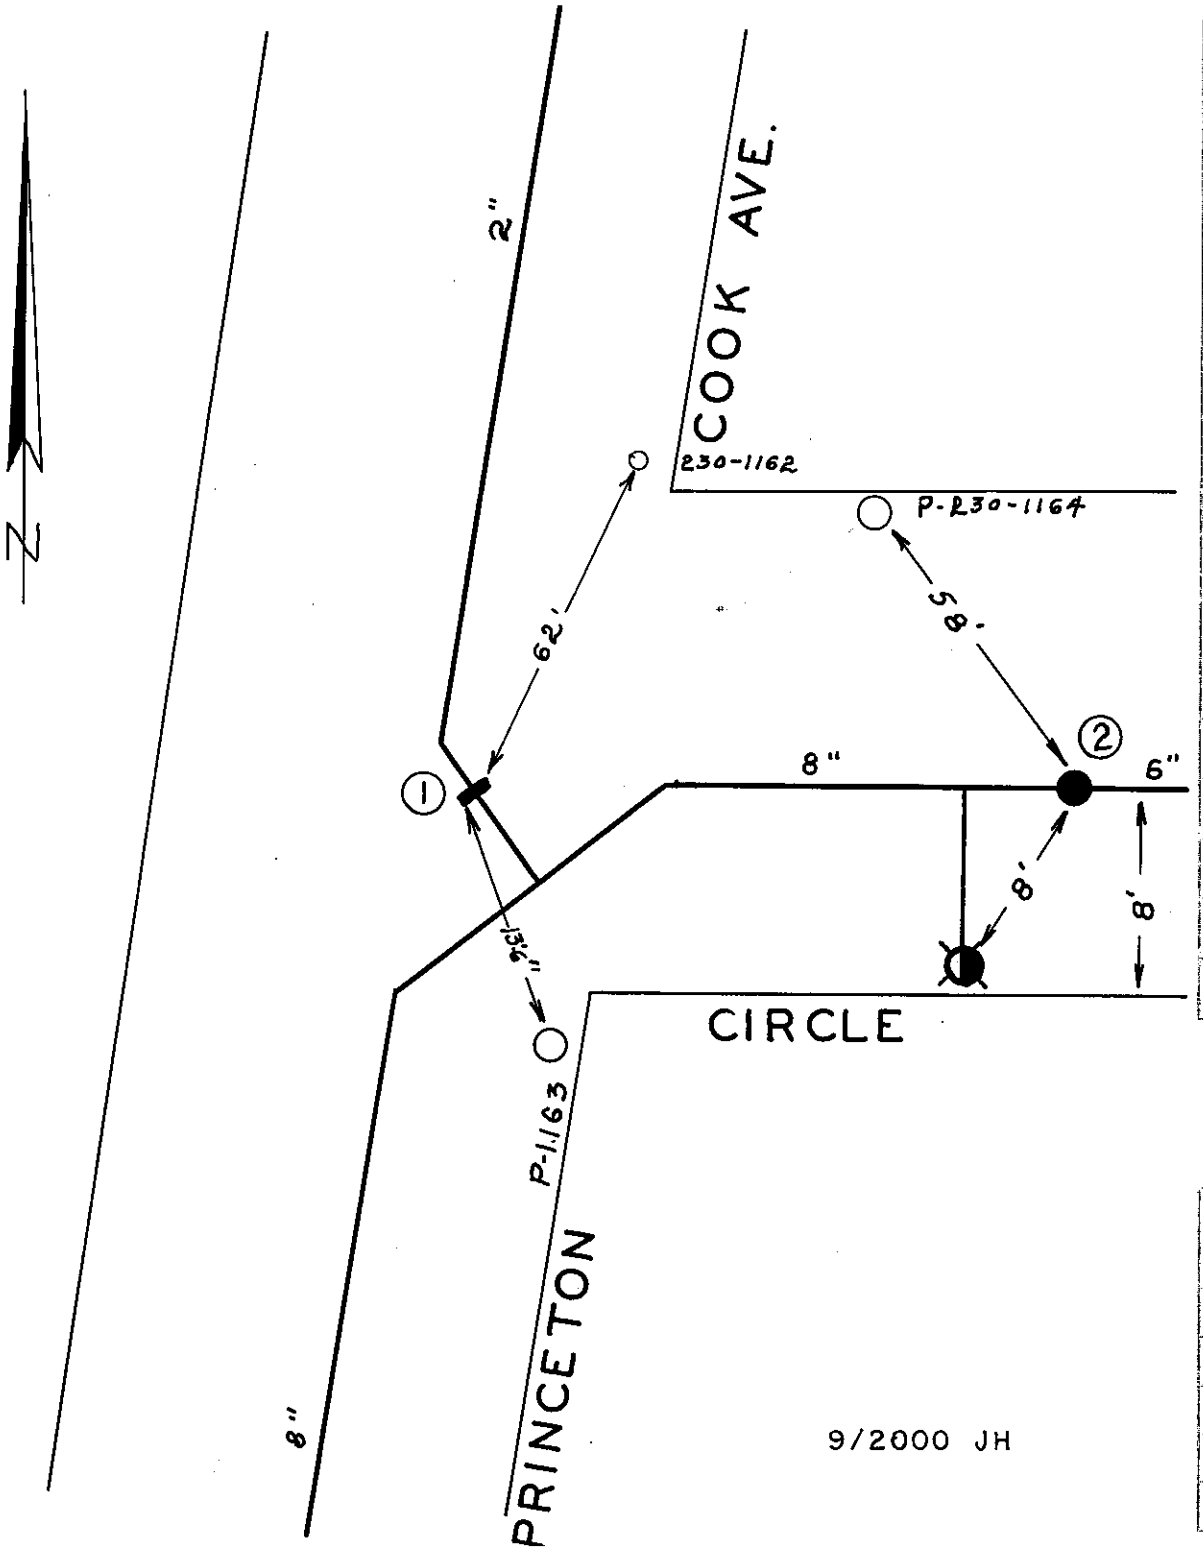

DATE	NO.	SIZE	MAKE	OPEN	TURNS
9-62	1	2"	DARLING	R	7
W.R.	2	6"			
	1	0	EPL		
	2	129'-E	EPL		

9/2000 JH

CITY OF ROANOKE — WATER DEPT.

VALVE DIAGRAM

COOK AVE. &

PRINCETON CIRCLE

SEC. MAP 317, 209 N.E.

DATE PAGE NO.