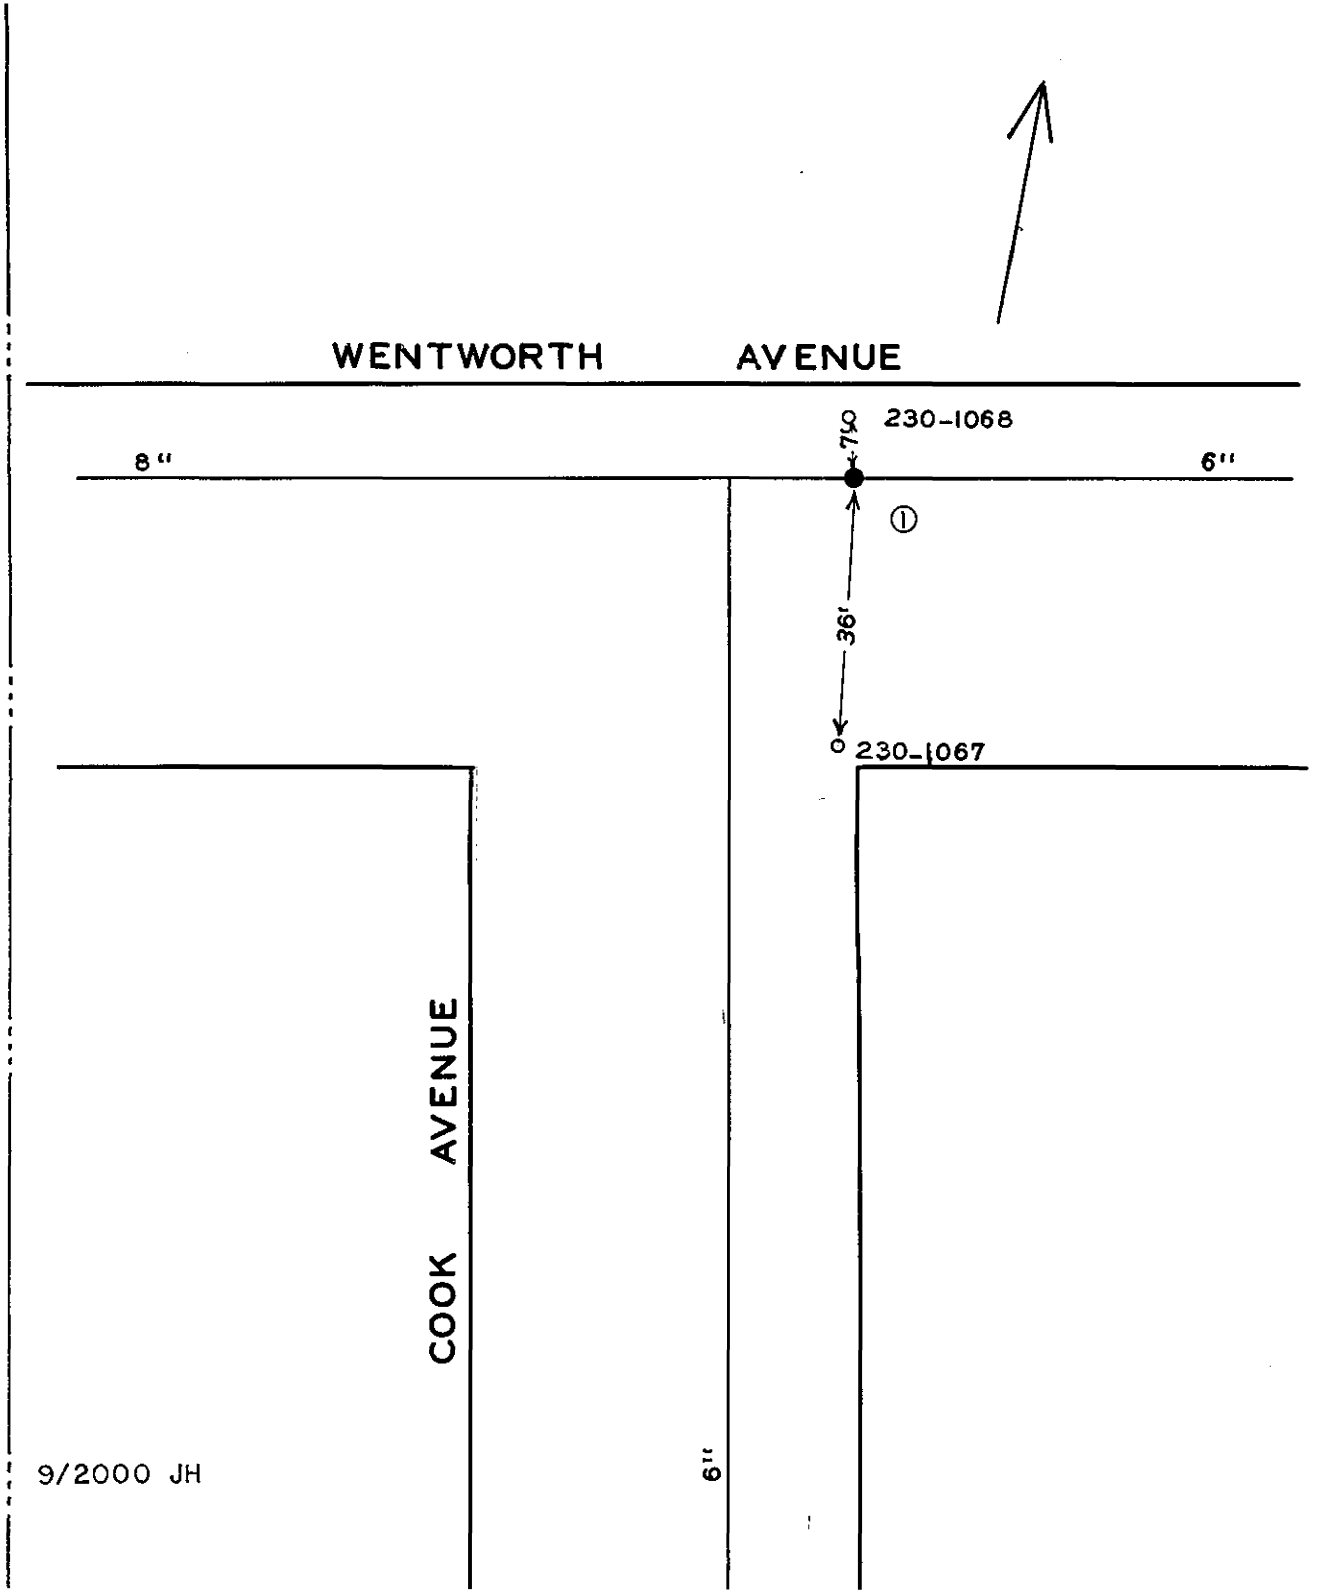

DATE	NO.	SIZE	MAKE	OPEN	TURNS
1-63	1	6"	MUELLER	R	
	1	0	E.P.L.		

CITY OF ROANOKE—WATER DEPT.

VALVE DIAGRAM

COOK AVENUE &

WENTWORTH AVENUE

SEC.-MAP 317 209 N.E.

DATE PAGE NO.