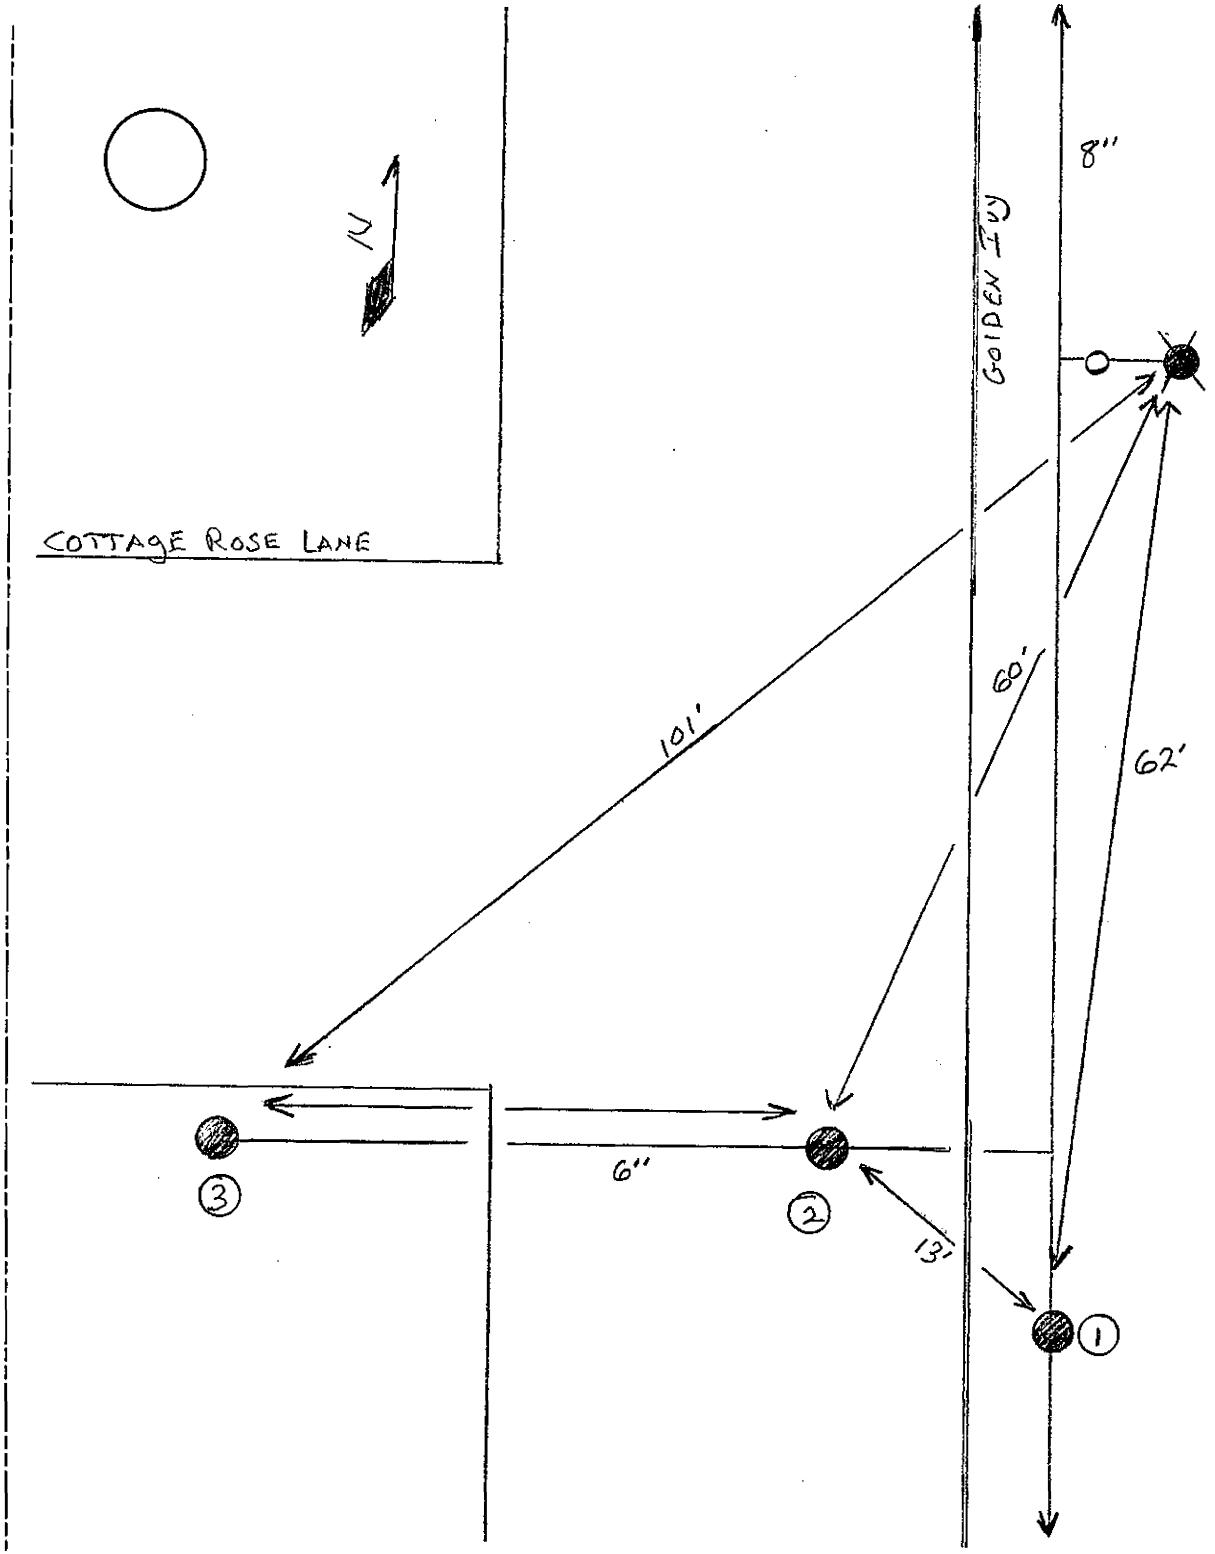

DATE	NO.	SIZE	MAKE	OPEN	TURNS
2004	1	8"	AMERICAN	L	27
2004	2	6"	AMERICAN	L	21
2004	3	6"	BLOWOFF		

WESTERN VIRGINIA WATER AUTHORITY

VALVE DIAGRAM

COTTAGE ROSE LANE AND

GOLDEN IVY

SECT. MAP COUNTY