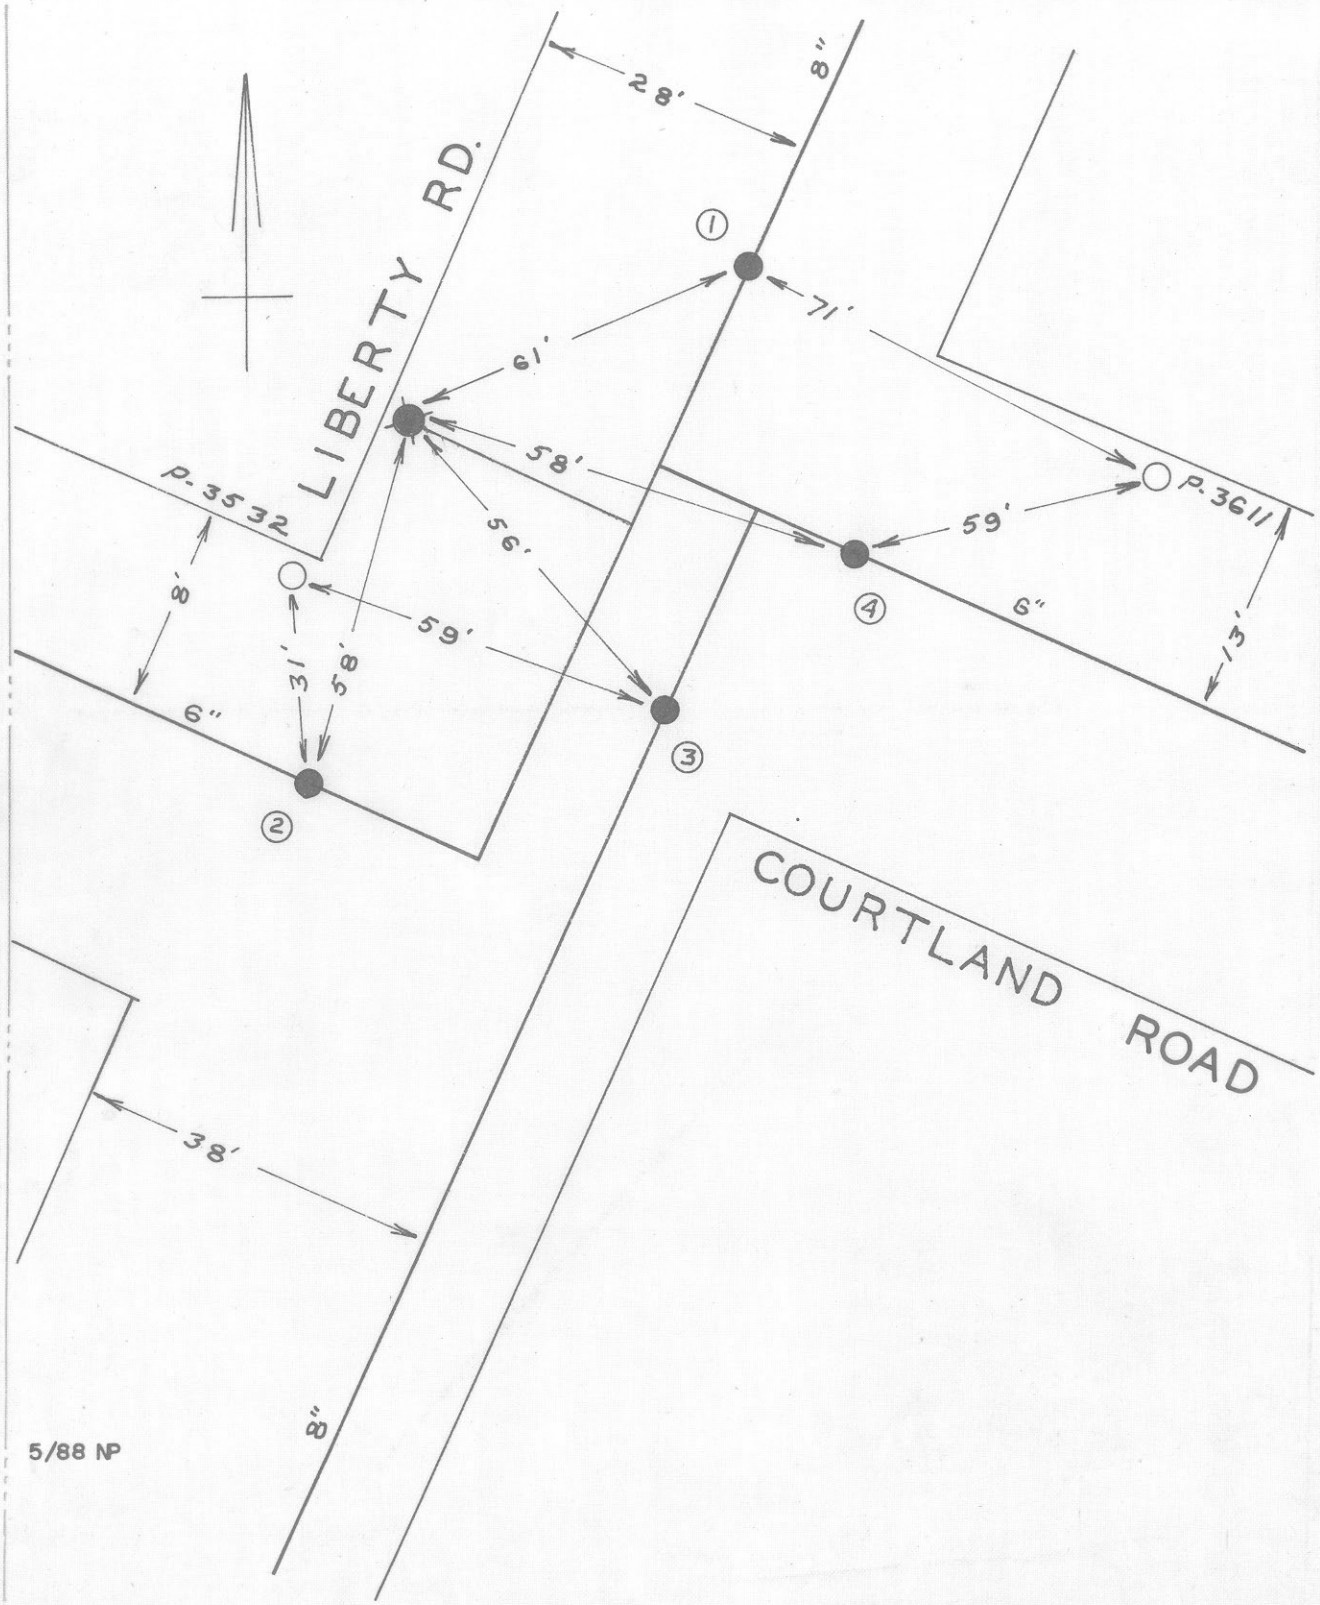

DATE	NO.	SIZE	MAKE	OPEN	TURNS
1948	1	8"			
1925	2	6"			
1963	3	8"			
1925	4	6"			
	1	0	NPL		
	2	12'-E	WPL		
	3	0	NPL		
	4	0	EPL		

CITY OF ROANOKE—WATER DEPT.

VALVE DIAGRAM

COURTLAND RD. &

LIBERTY RD. N. W. OR N. E.

SEC. MAP 206-308

DATE PAGE NO.

5/88 NP

"IMPERIAL" TRACING CLOTH
K & E CO., N. Y.