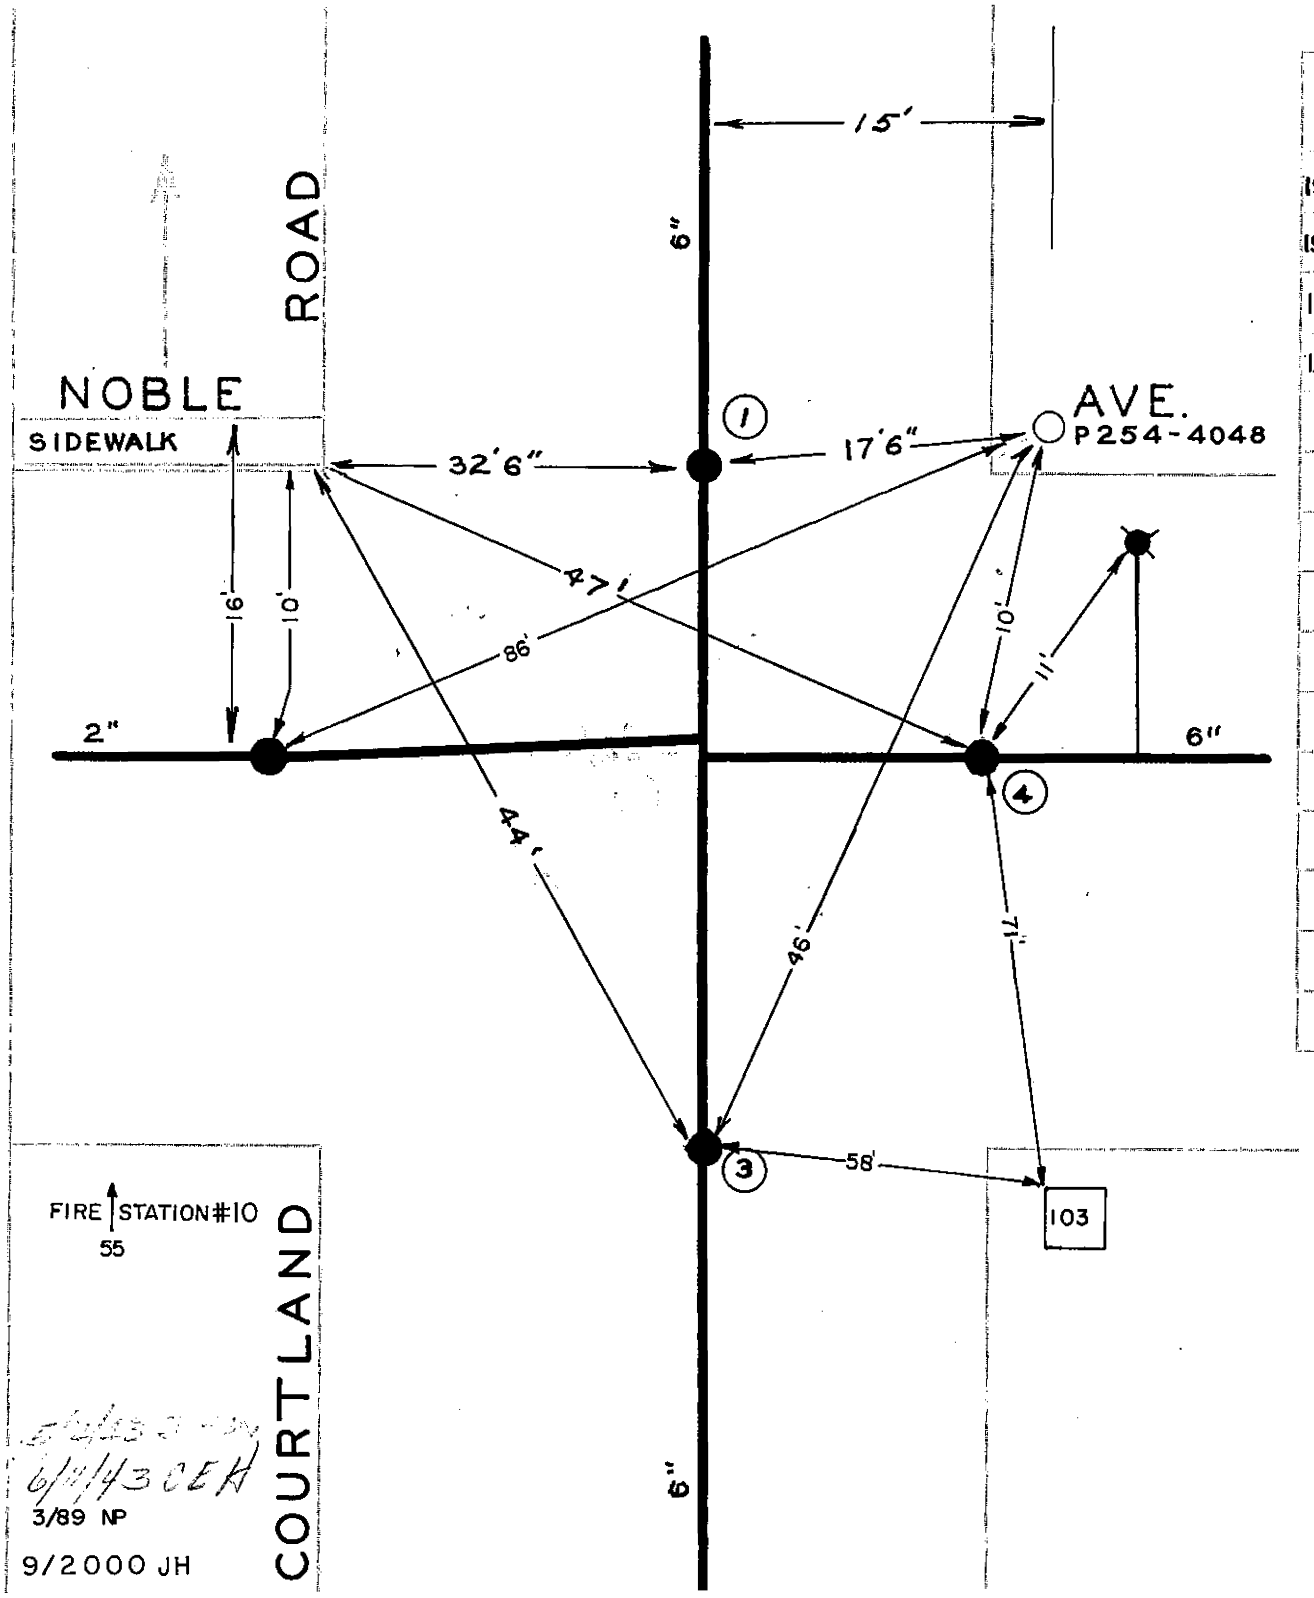

DATE	NO	SIZE	MAKE	OPEN	TURNS
1924	1	6"		R	20
1924	2	2"		R	7 1/2
1989	3	6"		R	
1989	4	6"		R	
	1	5'-S	NPL		
	2	10'-W	WPL		
	3				
	4				

CITY OF ROANOKE - WATER DEPT
VALVE DIAGRAM

COURTLAND RD. &
NOBLE AVE. N.E.

SHEET NO. 308

DATE PAGE NO NE