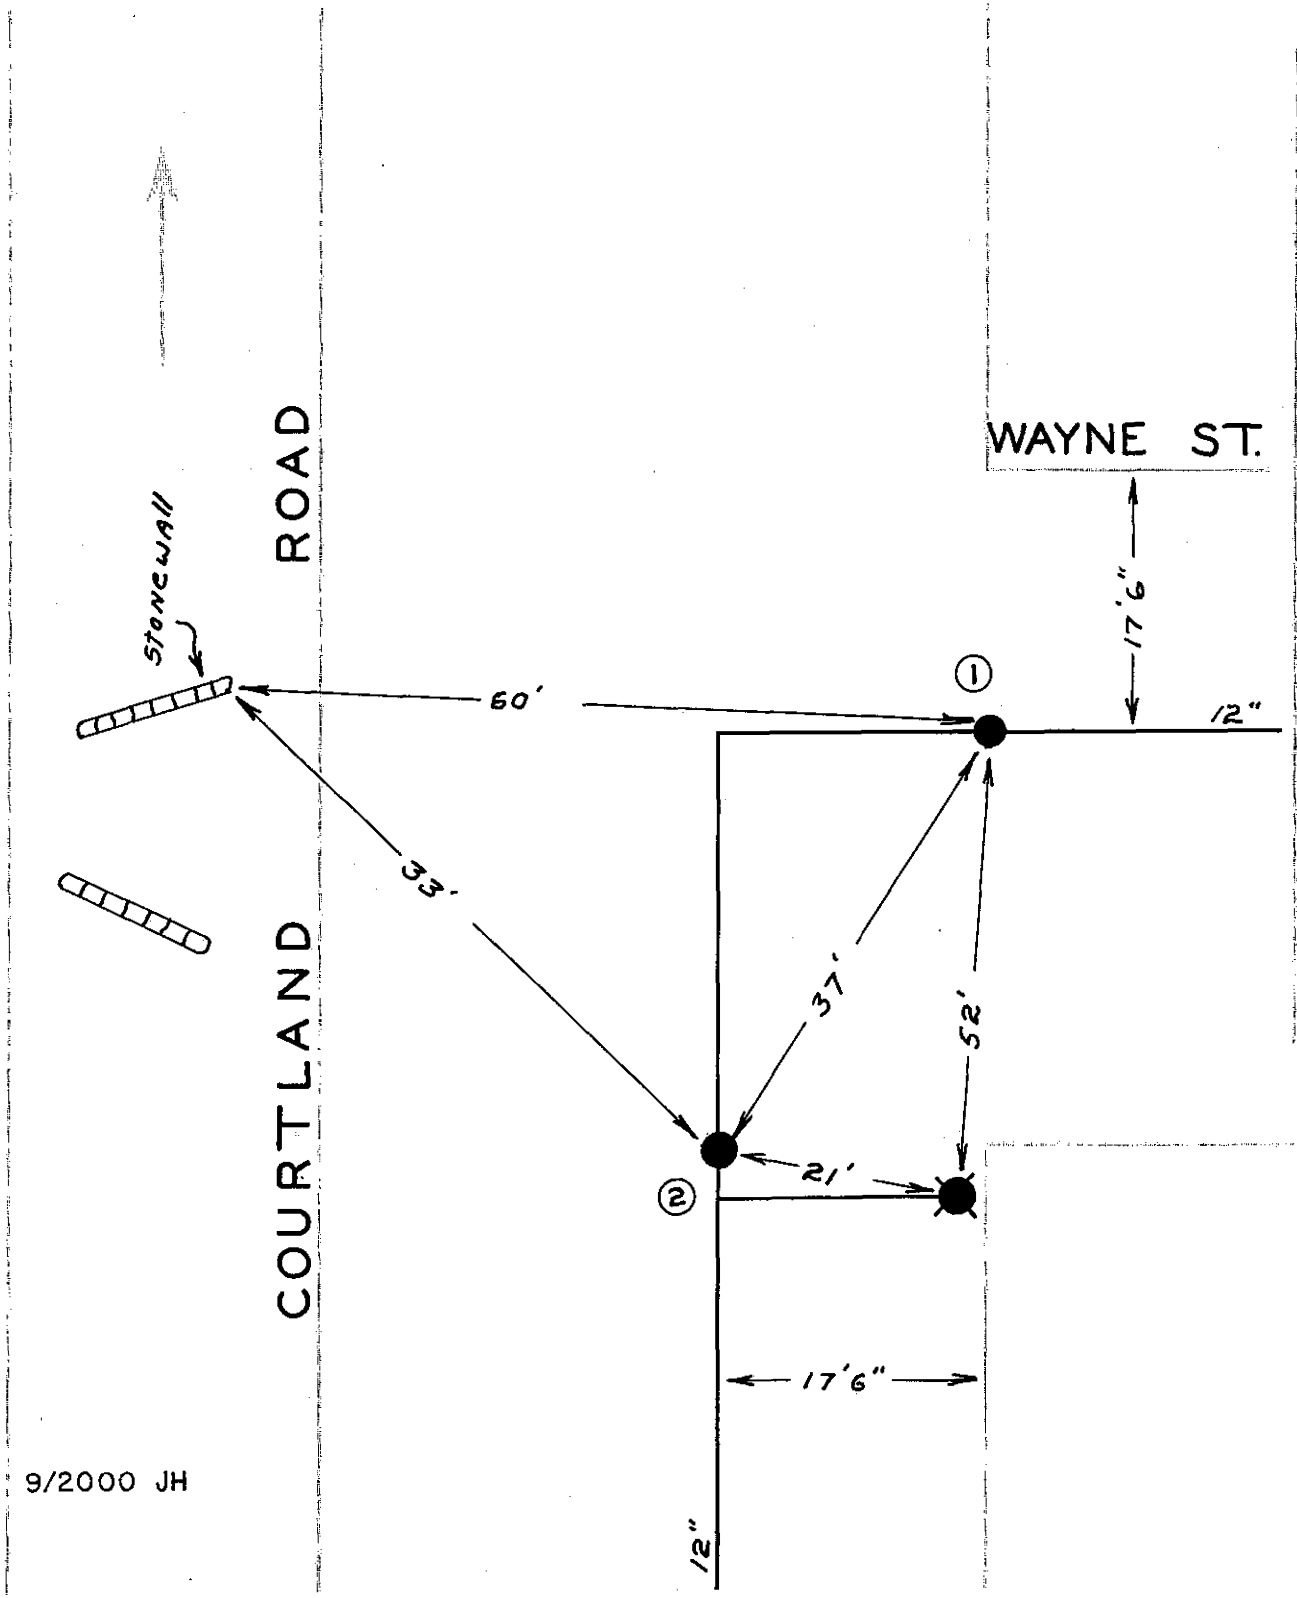

DATE	NO.	SIZE	MAKE	OPEN	TURNS
	1	12"	MUELLER	R	
	2	12"	MUELLER	R	
	1	0	EPL		
	2	0	SPL		

CITY OF ROANOKE - WATER DEPT
VALVE DIAGRAM
COURTLAND RD. &
WAYNE ST. N.E.

SEC. MAP 307
DATE: PAGE 1/2