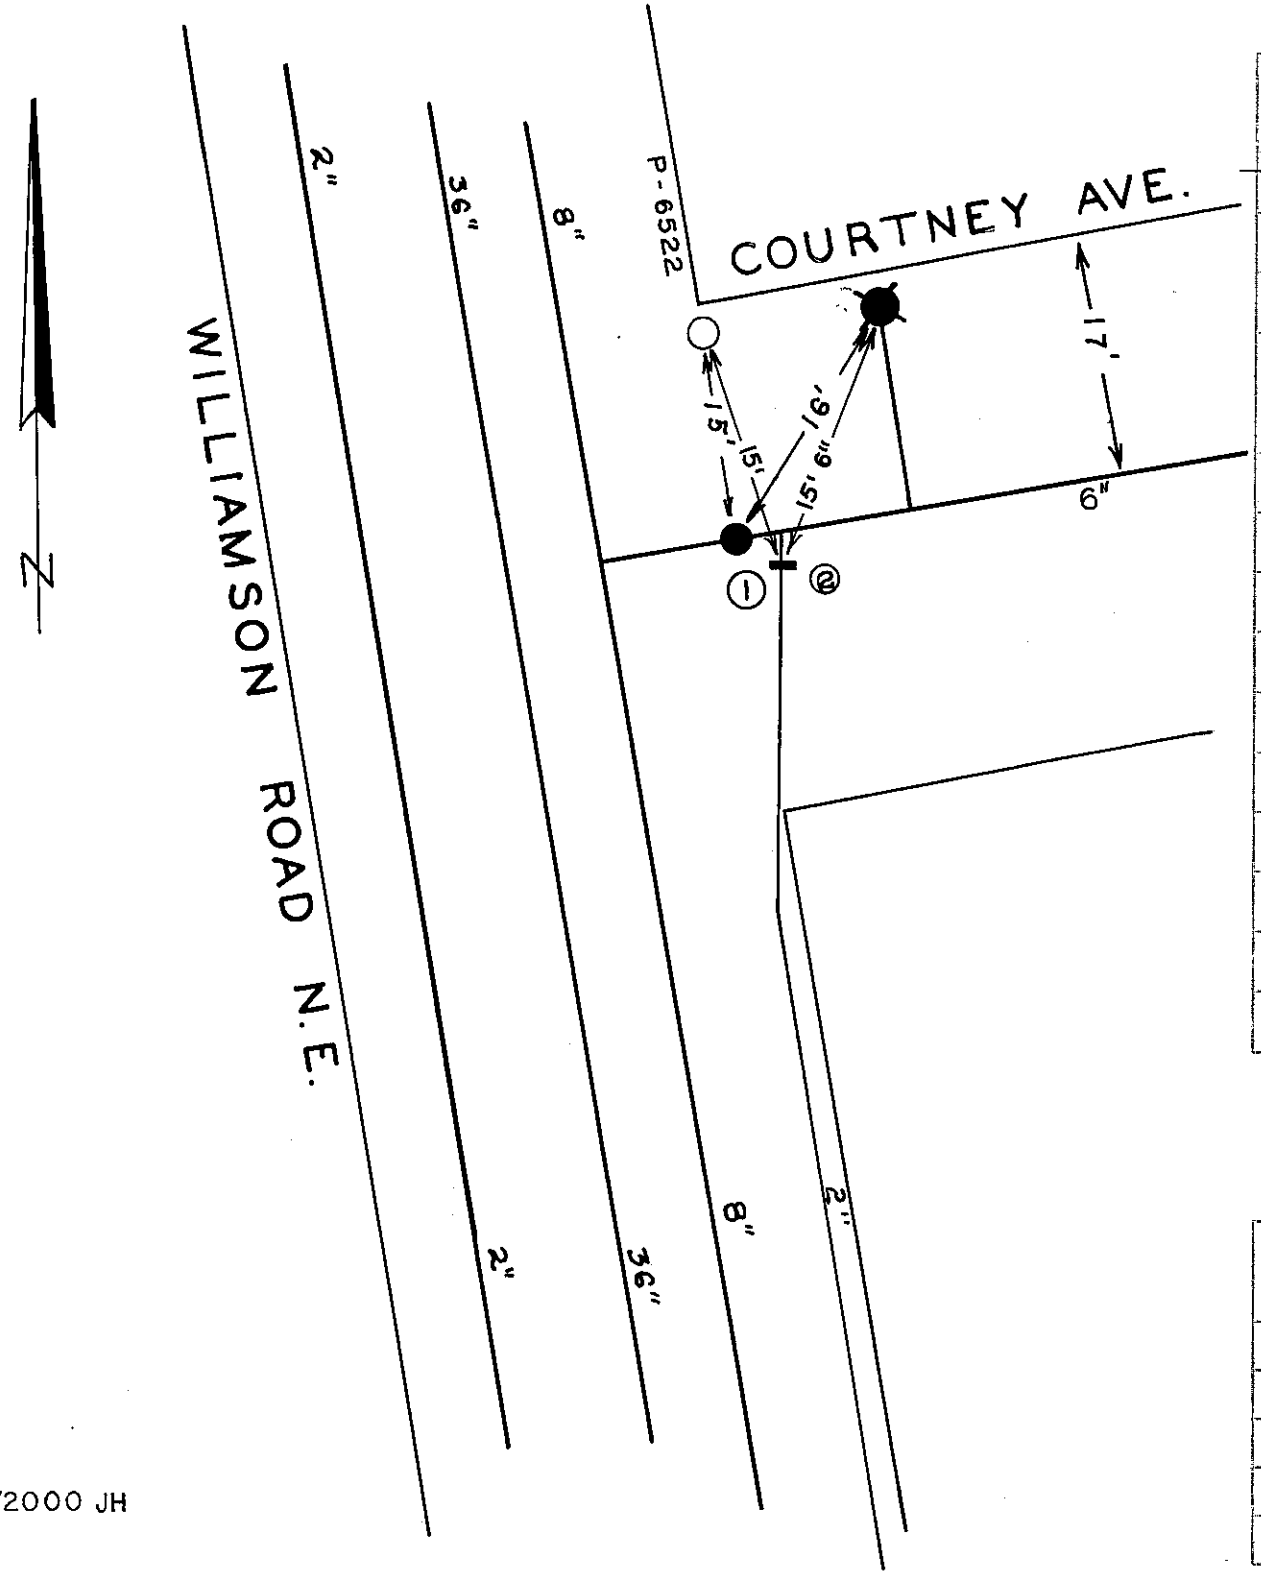

DATE	NO.	SIZE	MAKE	OPEN	TURNS
53	1	6"	MUELLER	R	20
8-62	2	2"	MISC	L	
	1	0	EPL		

CITY OF ROANOKE – WATER DEPT.

VALVE DIAGRAM

COURTNEY AVE. &

WILLIAMSON RD.

SEC. MAP 309 N.E.

DATE PAGE NO.

9/2000 JH