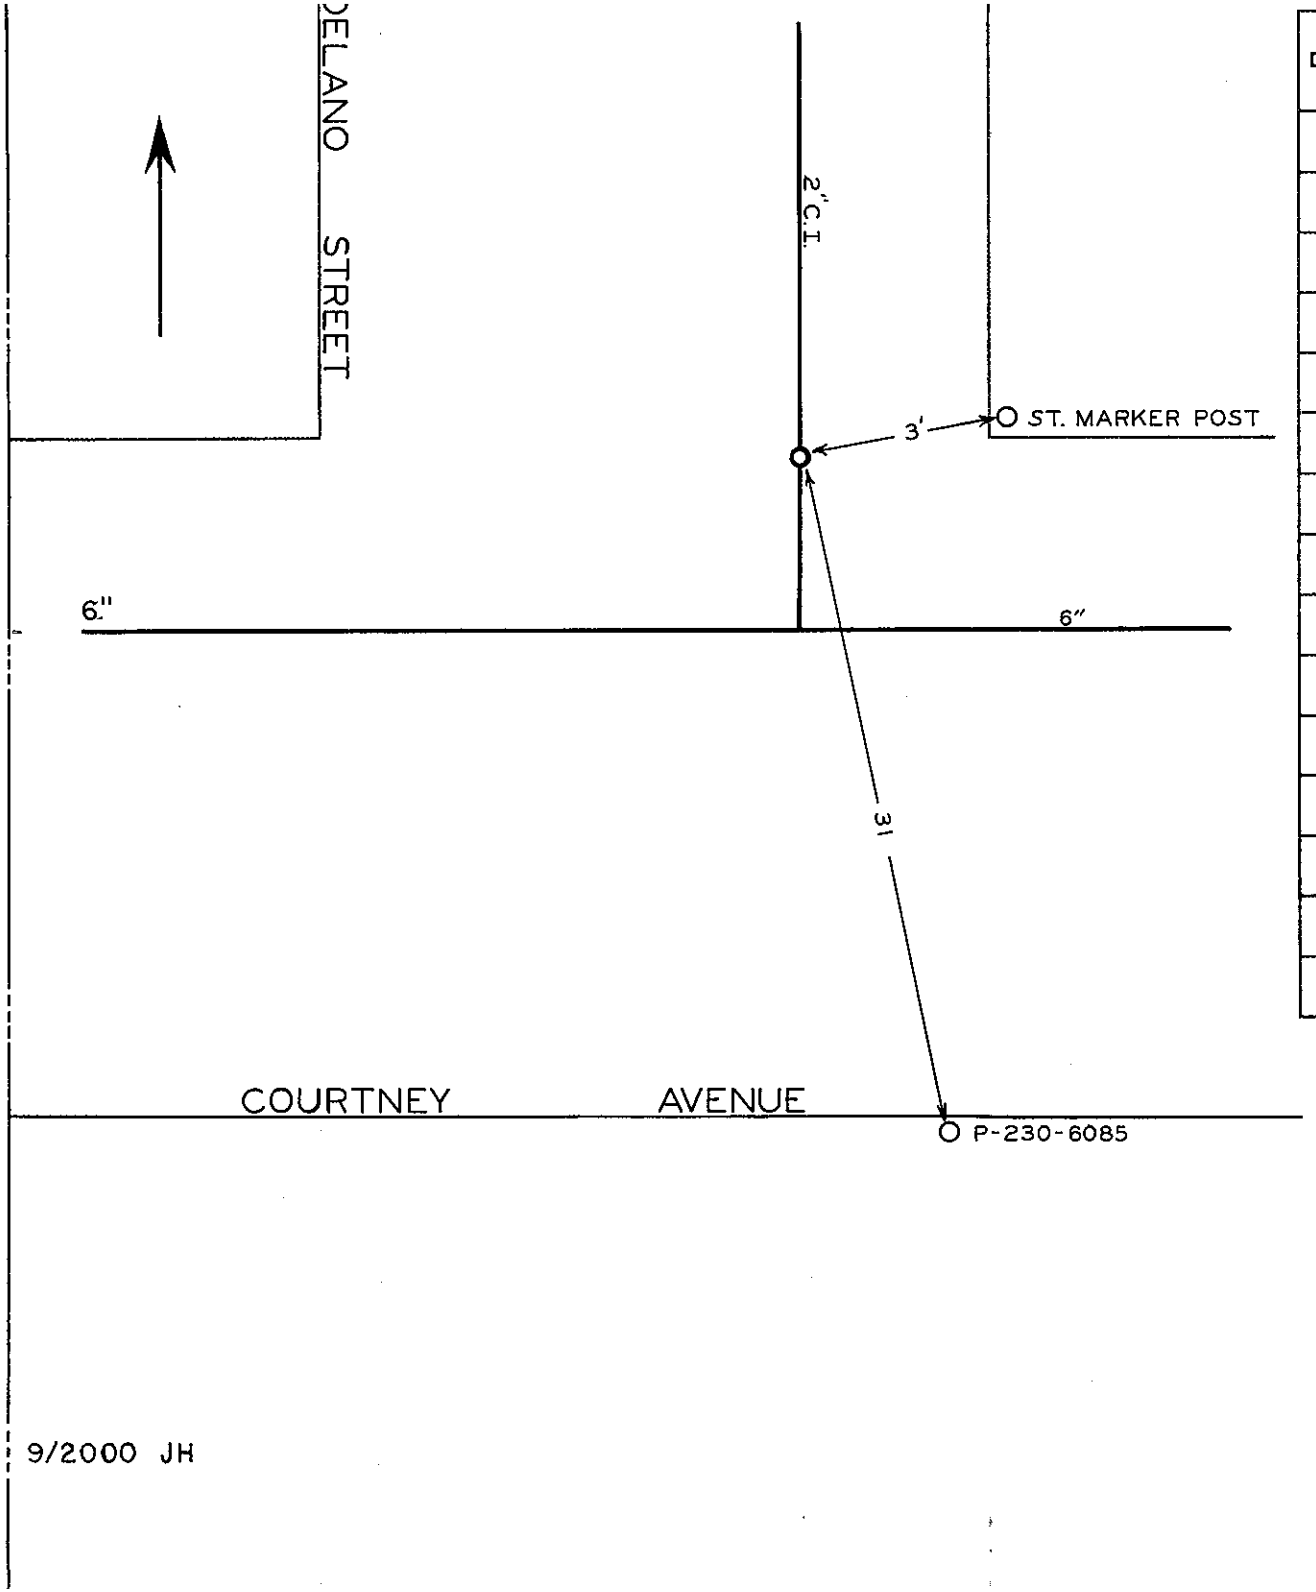

DATE	NO.	SIZE	MAKE	OPEN	TURNS
69	1	2"	DARLING	R	9
	1	2'-S	N.P.L.		

CITY OF ROANOKE—WATER DEP'T

VALVE DIAGRAM

COURTNEY AVENUE &

DELANO STREET

SEC. MAP 309, 313 N.E.

DATE PAGE NO.