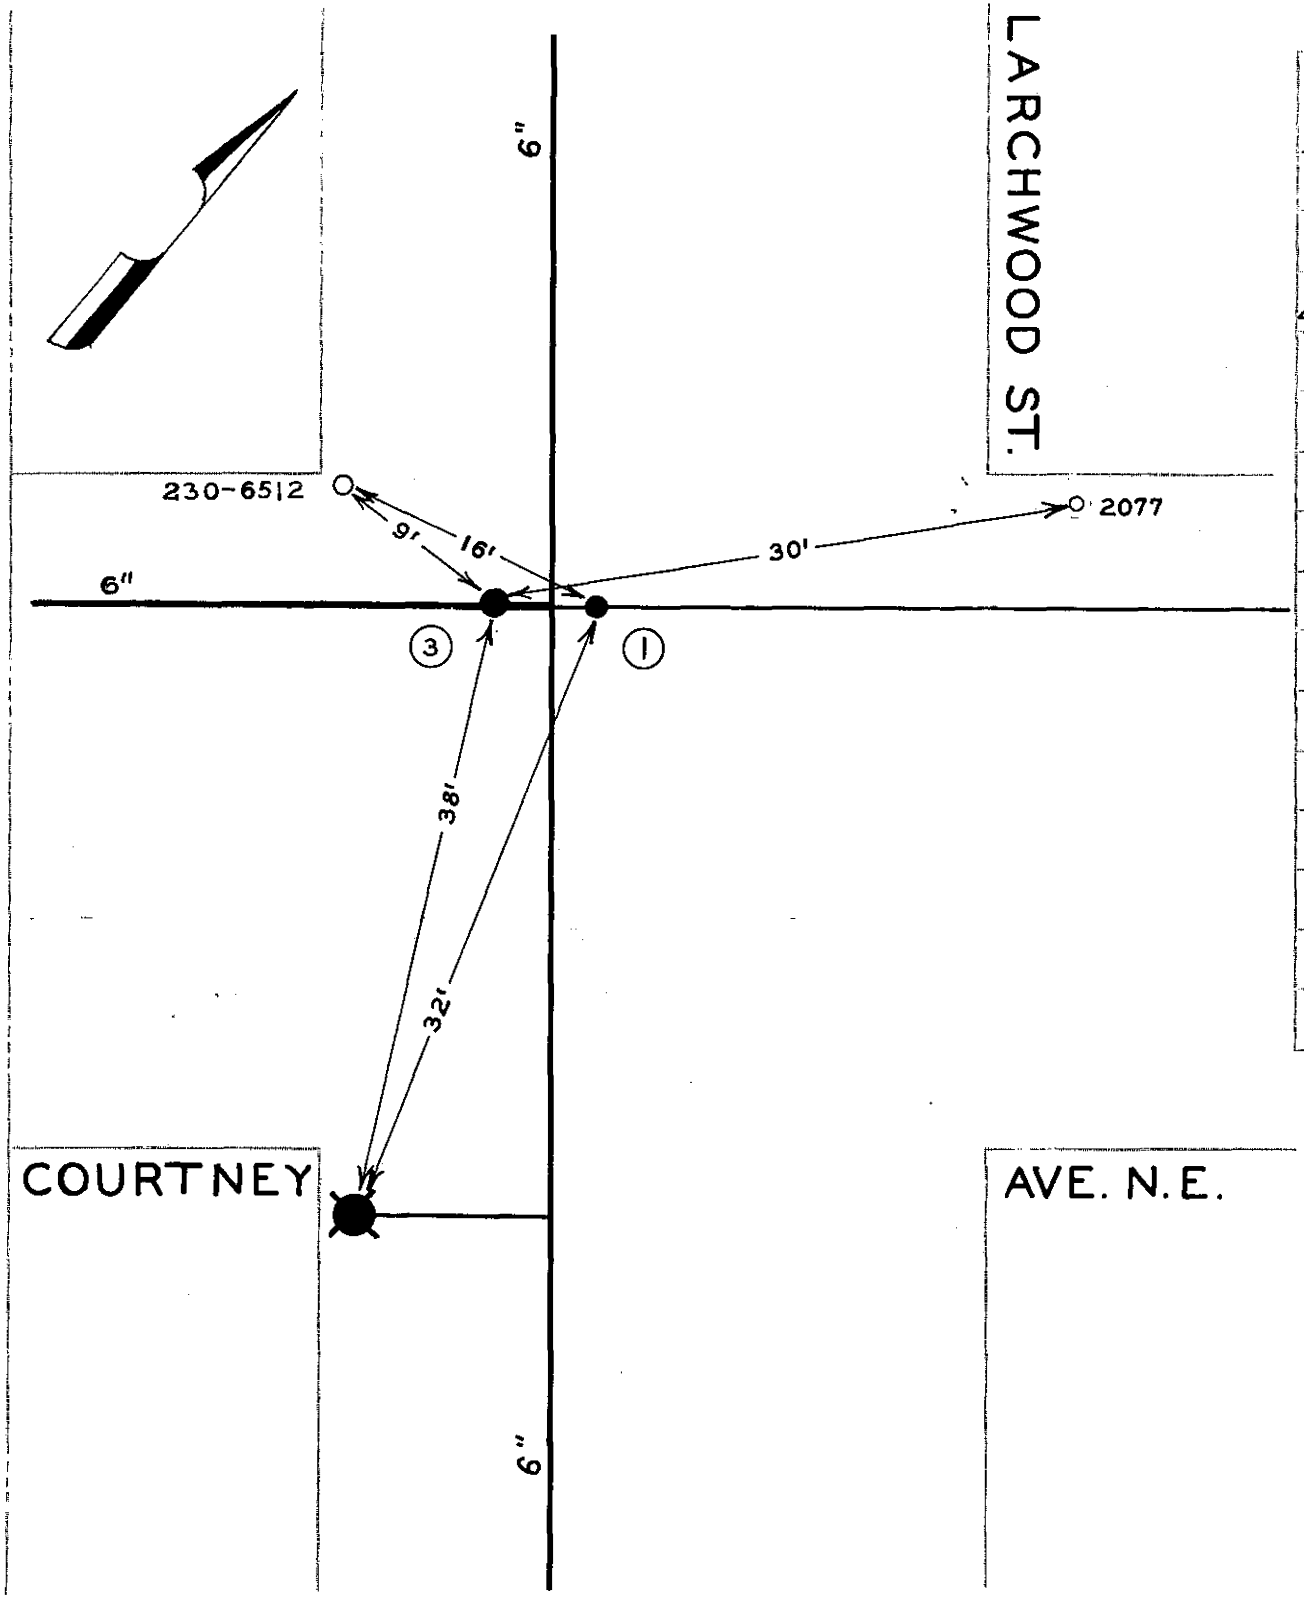

DATE	NO	SIZE	MARK	OPEN	RING
8-63	1	6"	DARLING	R	
4-62	3	6"	DARLING	R	
	3	$7\frac{1}{2}$'E	W.P.L.		

CITY OF ROANOKE WATER DEP'T

VALVE DIAGRAM

COURTNEY AVE. &

LARCHWOOD ST.

SEC. MAP 309 N.E.

DATE PAGE NO