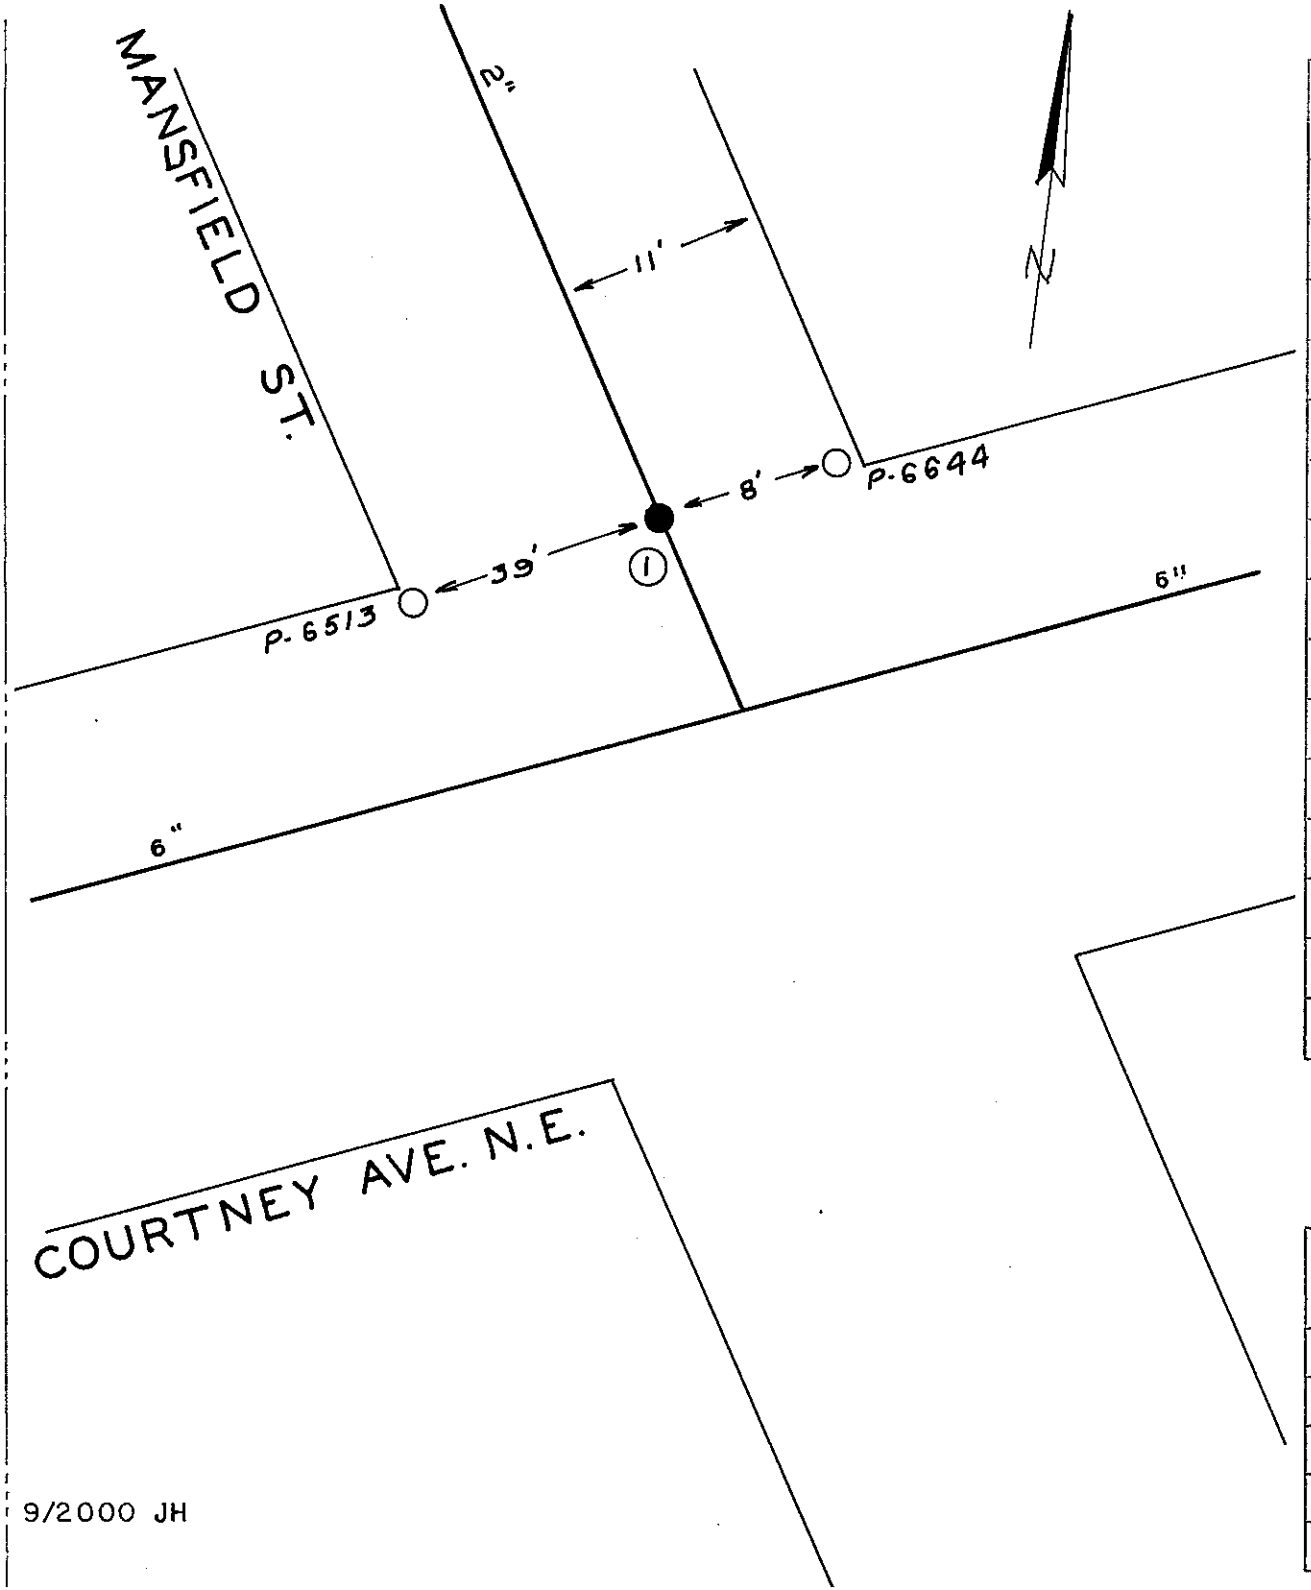

DATE	NO.	SIZE	MAKE	OPEN	TURNS
	1	2"	DARLING	R	7
	1	0	NPL		

CITY OF ROANOKE—WATER DEPT.

VALVE DIAGRAM

COURTNEY AVE. &

MANSFIELD ST. N. E.

SEC. MAP 309, 313

DATE PAGE NO.

9/2000 JH

PERIAL" TRACING CLOTH
K & E CO., N. Y.