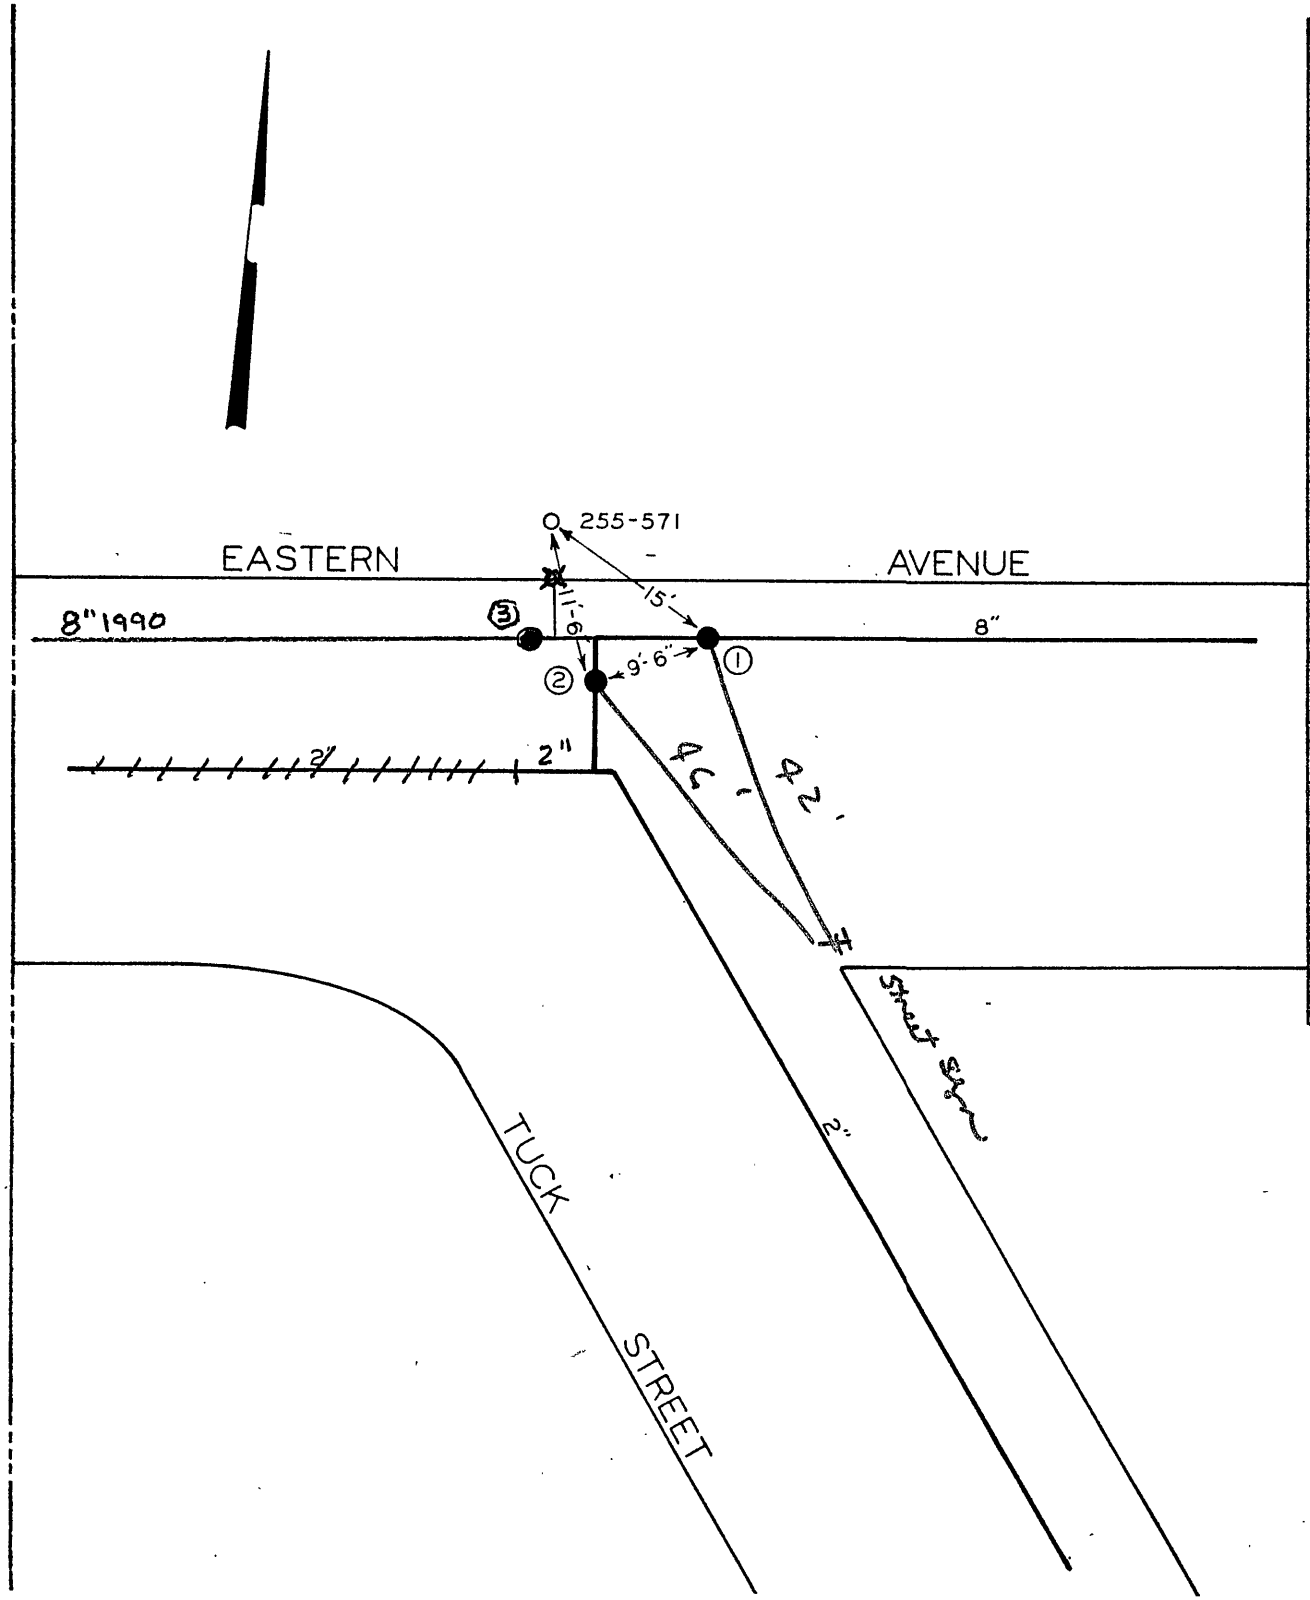

DATE	NO.	SIZE	MAKE	OPEN	TURNS
72	1	8"	MUELLER	R	27
73	2	2"	MISC.	R	
1990	3	8"	MUELLER	R	

CITY OF ROANOKE—WATER DEP'T

VALVE DIAGRAM

EASTERN AVENUE &

TUCK STREET N.E.

SEC. MAP 322

DATE SEP 1973 PAGE NO.