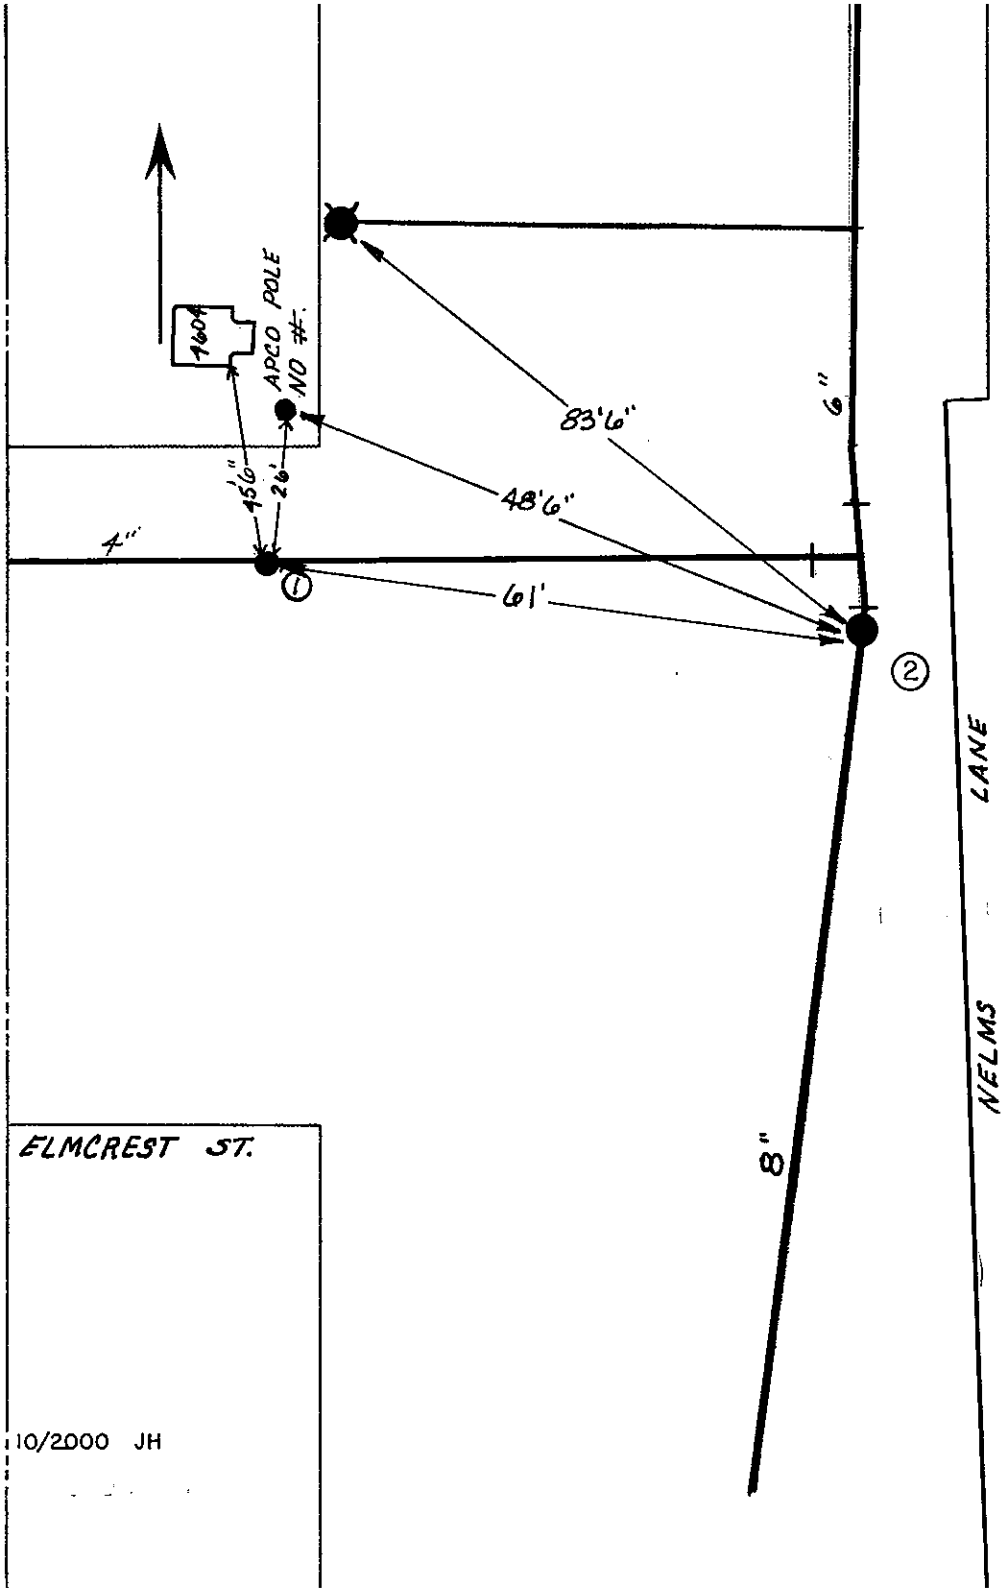

DATE	NO.	SIZE	MAKE	OPEN	TURNS
1973	/	4"		L	15
11-82	2	6"		L	21

CITY OF ROANOKE—WATER DEP'T

VALVE DIAGRAM

ELMCREST STREET AND

NELMS LANE

SEC. MAP 739 N.E.

DATE JULY 11, 1980 PAGE NO.