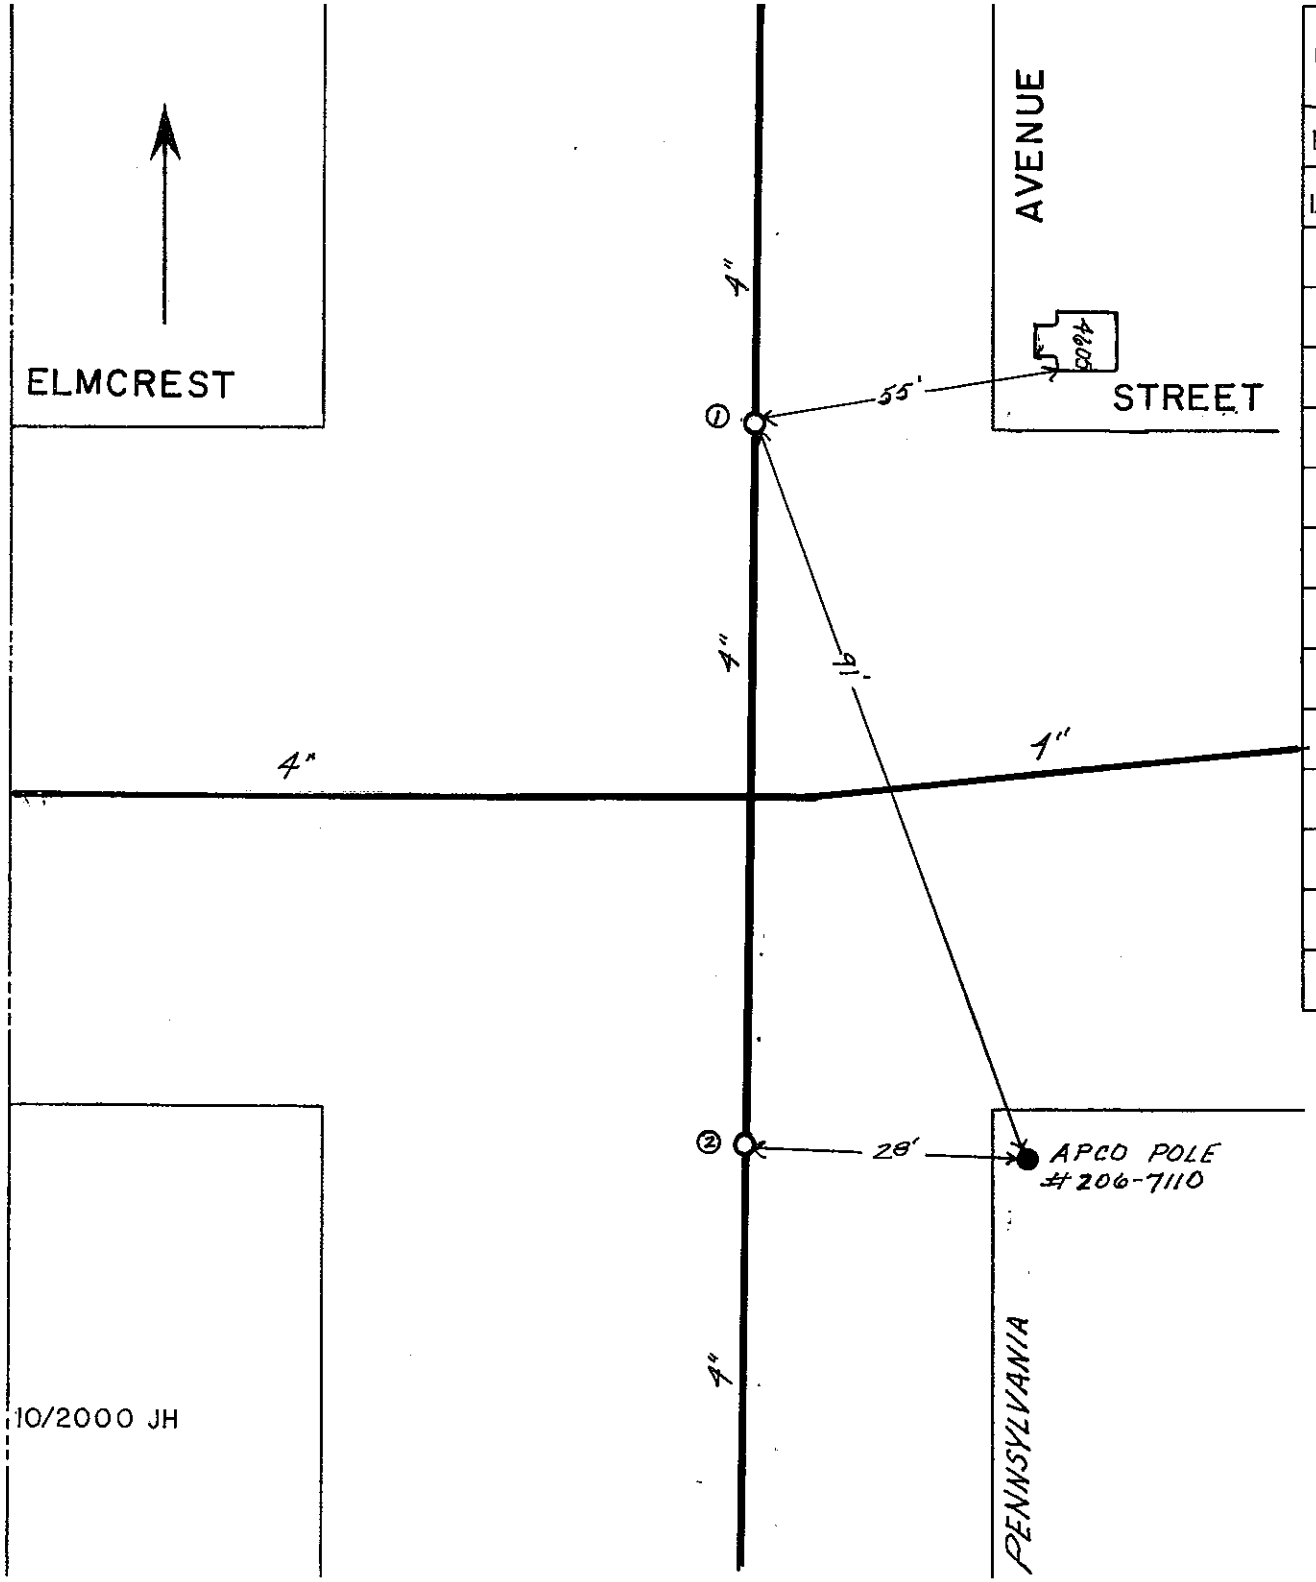

DATE	NO.	SIZE	MAKE	OPEN	TURNS	
1973	1	4"		R		#one b
1973	2	4"		R		#one b

CITY OF ROANOKE—WATER DEP'T

VALVE DIAGRAM

ELMCREST STREET AND

PENNSYLVANIA AVE.

SEC. MAP 739 N.E.

DATE JULY 11, 1980 PAGE NO.