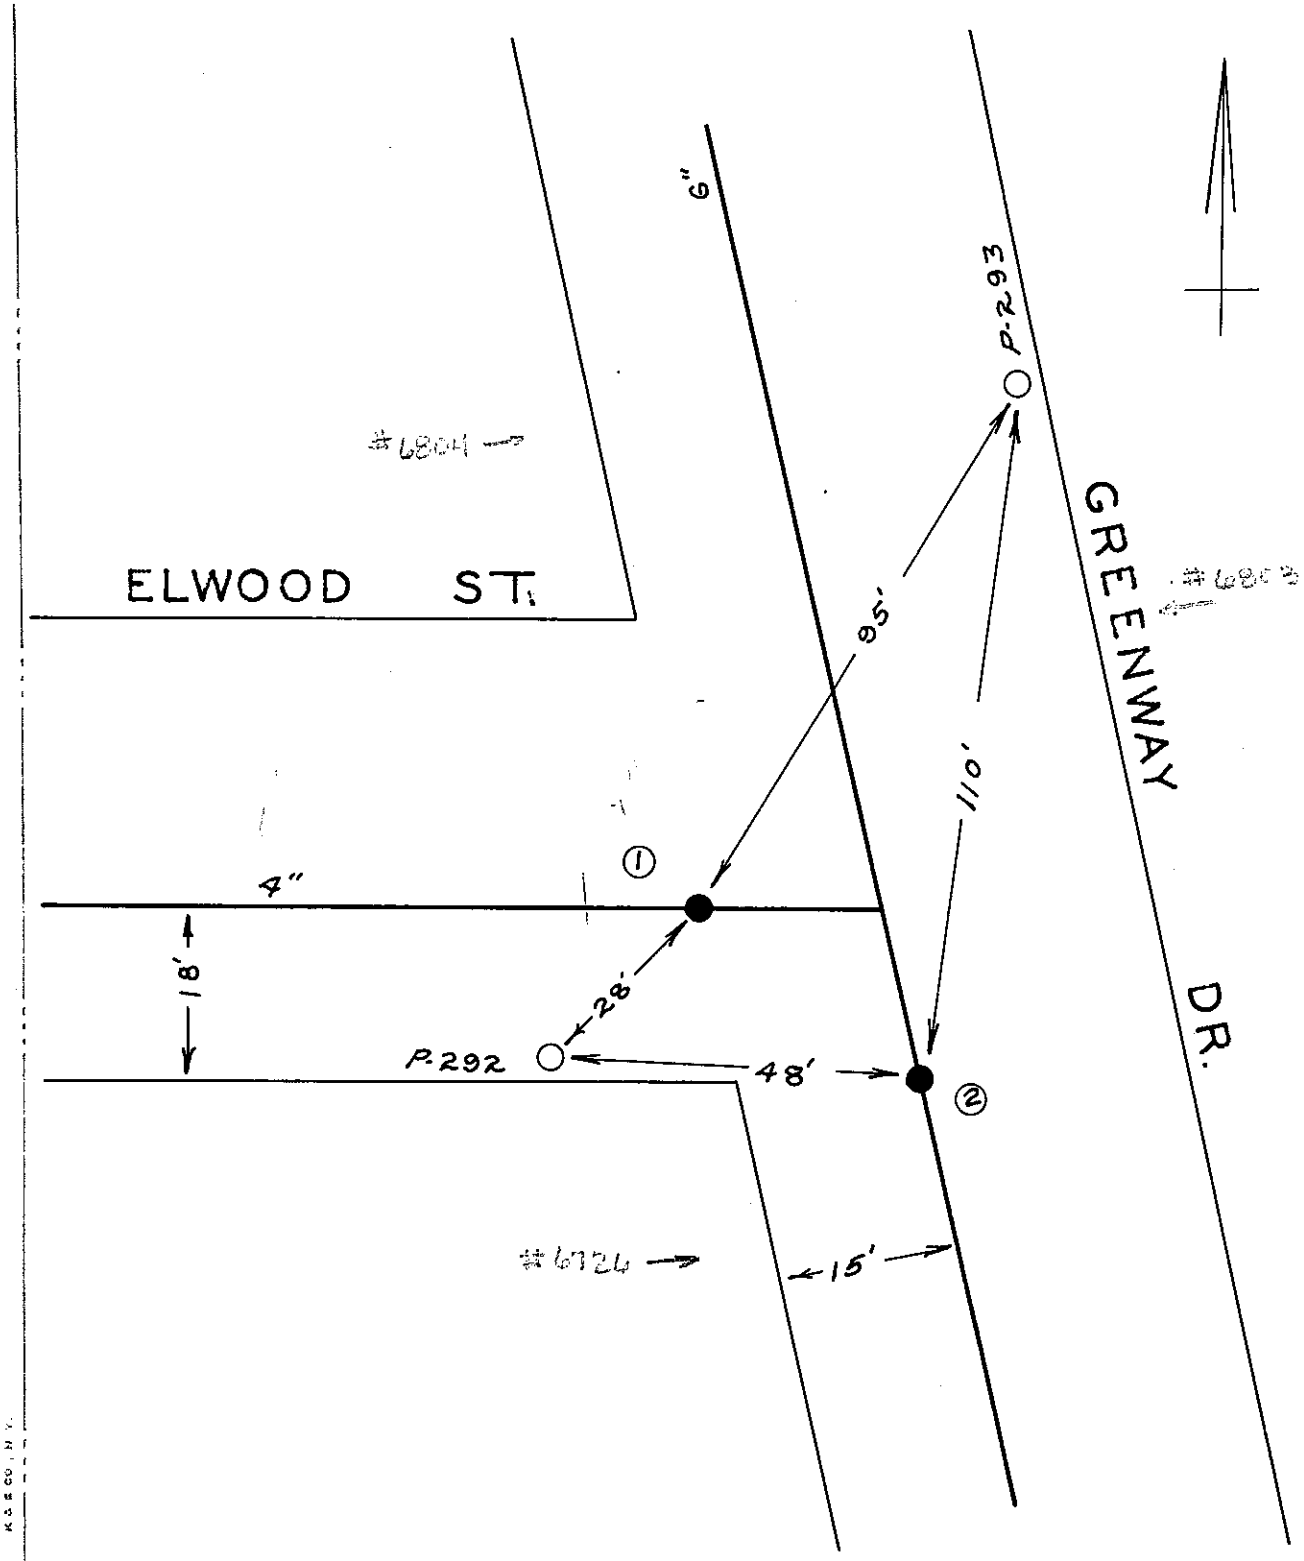

DATE	NO.	SIZE	MAKE	OPEN	TURNS
	1	4"			
	2	6"			
	1	0	WPL		
	2	0	SPL		

CITY OF ROANOKE — WATER DEPT.

VALVE DIAGRAM

ELWOOD ST. & GREENWAY DRIVE N.E.

SEQ. PAGE 16 Roanoke County

DATE PAGE NO.

K & E CO. N. Y.