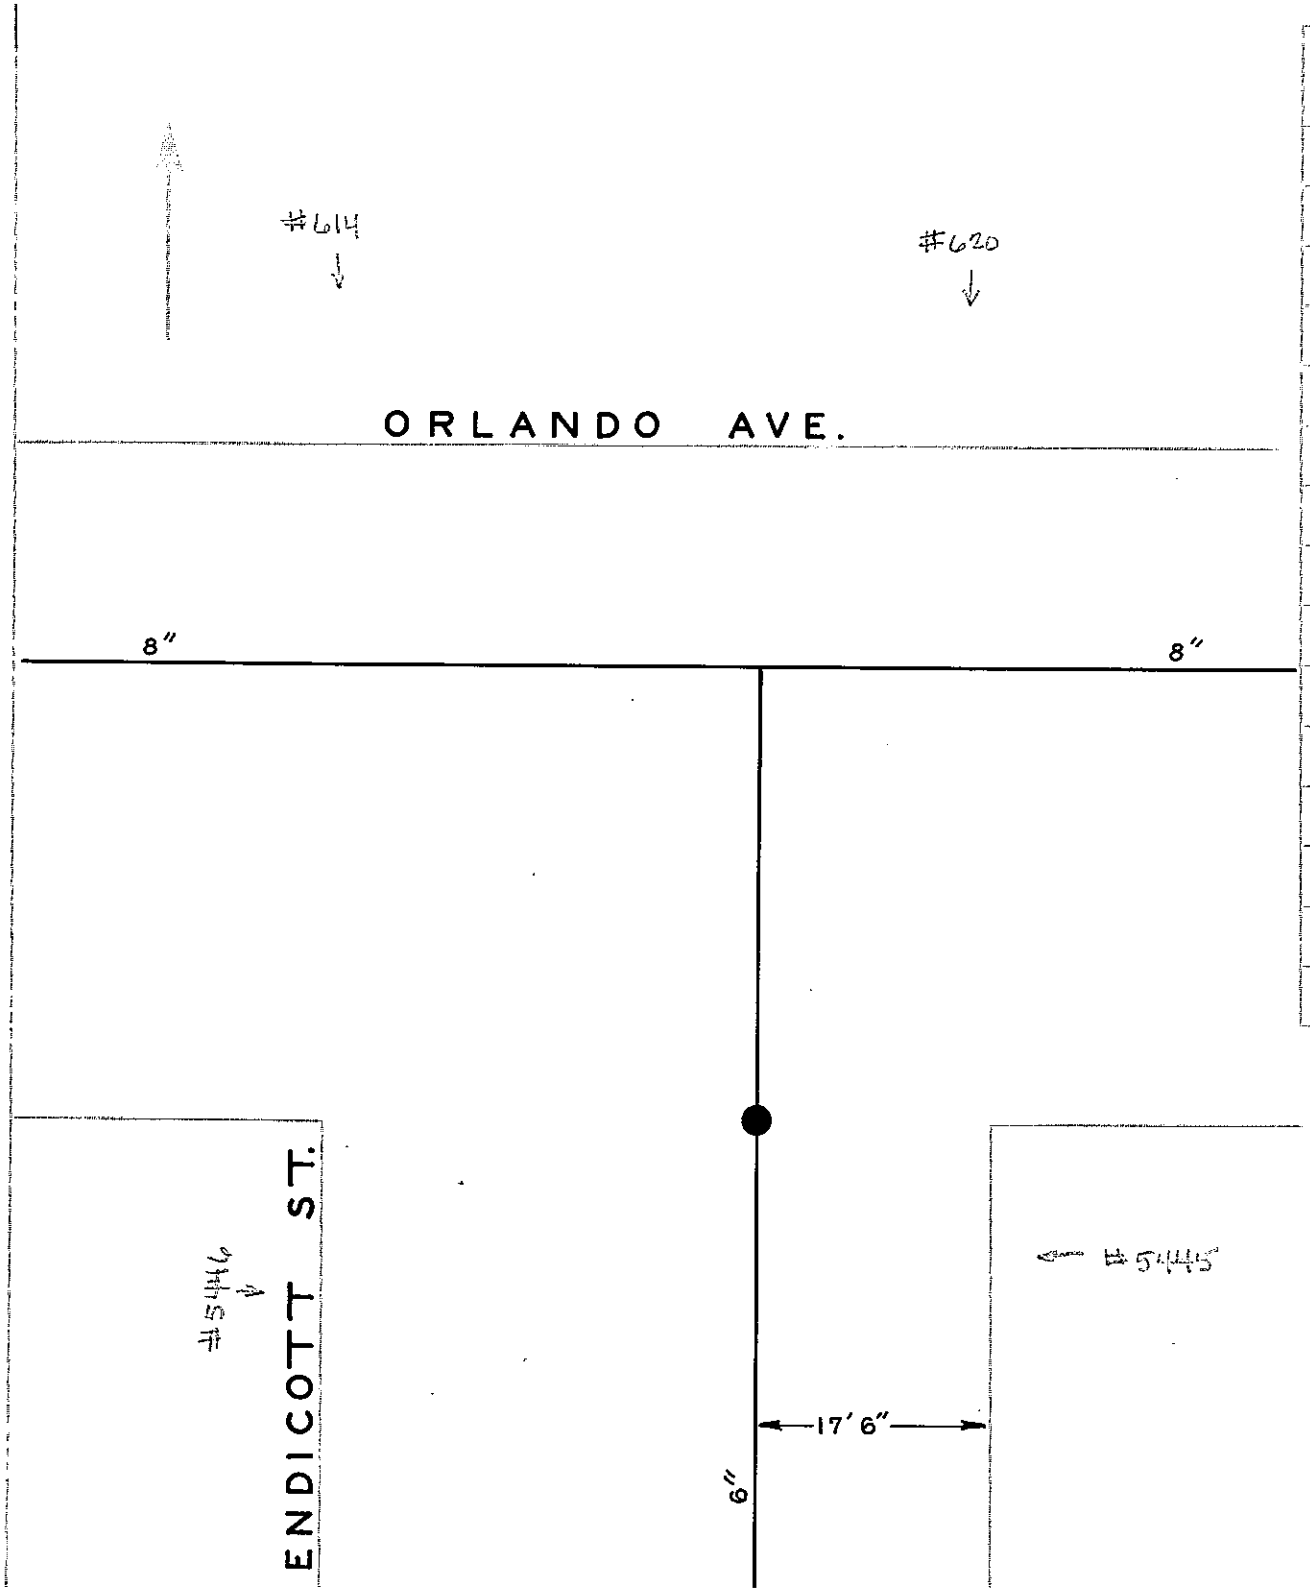

DATE	NO	SIZE	MAKE	OPER	TURNS
'60	1	6"	MUELLER	R	
	1	0	SPL		

CITY OF ROANOKE – WATER DEP'T

VALVE DIAGRAM

ENDICOTT ST. &

ORLANDO AVE. N. E.

SEE MAP 33 Roanoke County

DATE PAGE NO