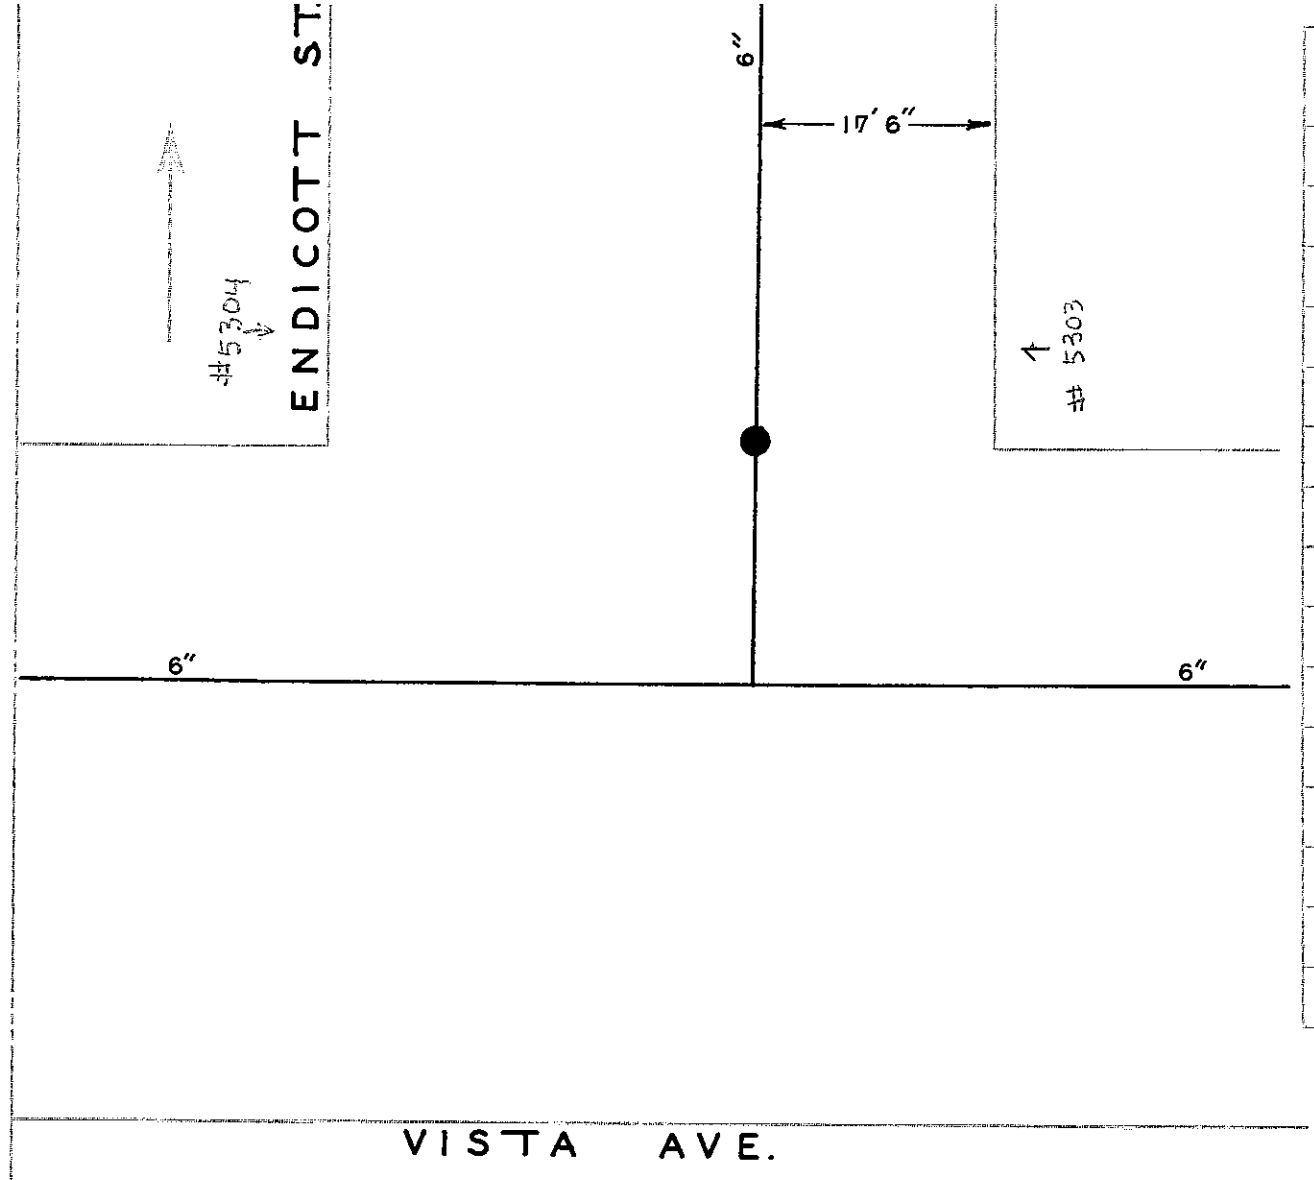

DATE	NO.	SIZE	MARK	OTHER	THERE
60	1	6"	MUELLER	R	
	1	0	NPL		

CITY OF ROANOKE — WATER DEPT

VALVE DIAGRAM

ENDICOTT ST. &

VISTA AVE. N. E.

SPC MAP 33 Roanoke County

DATE PAGE NO