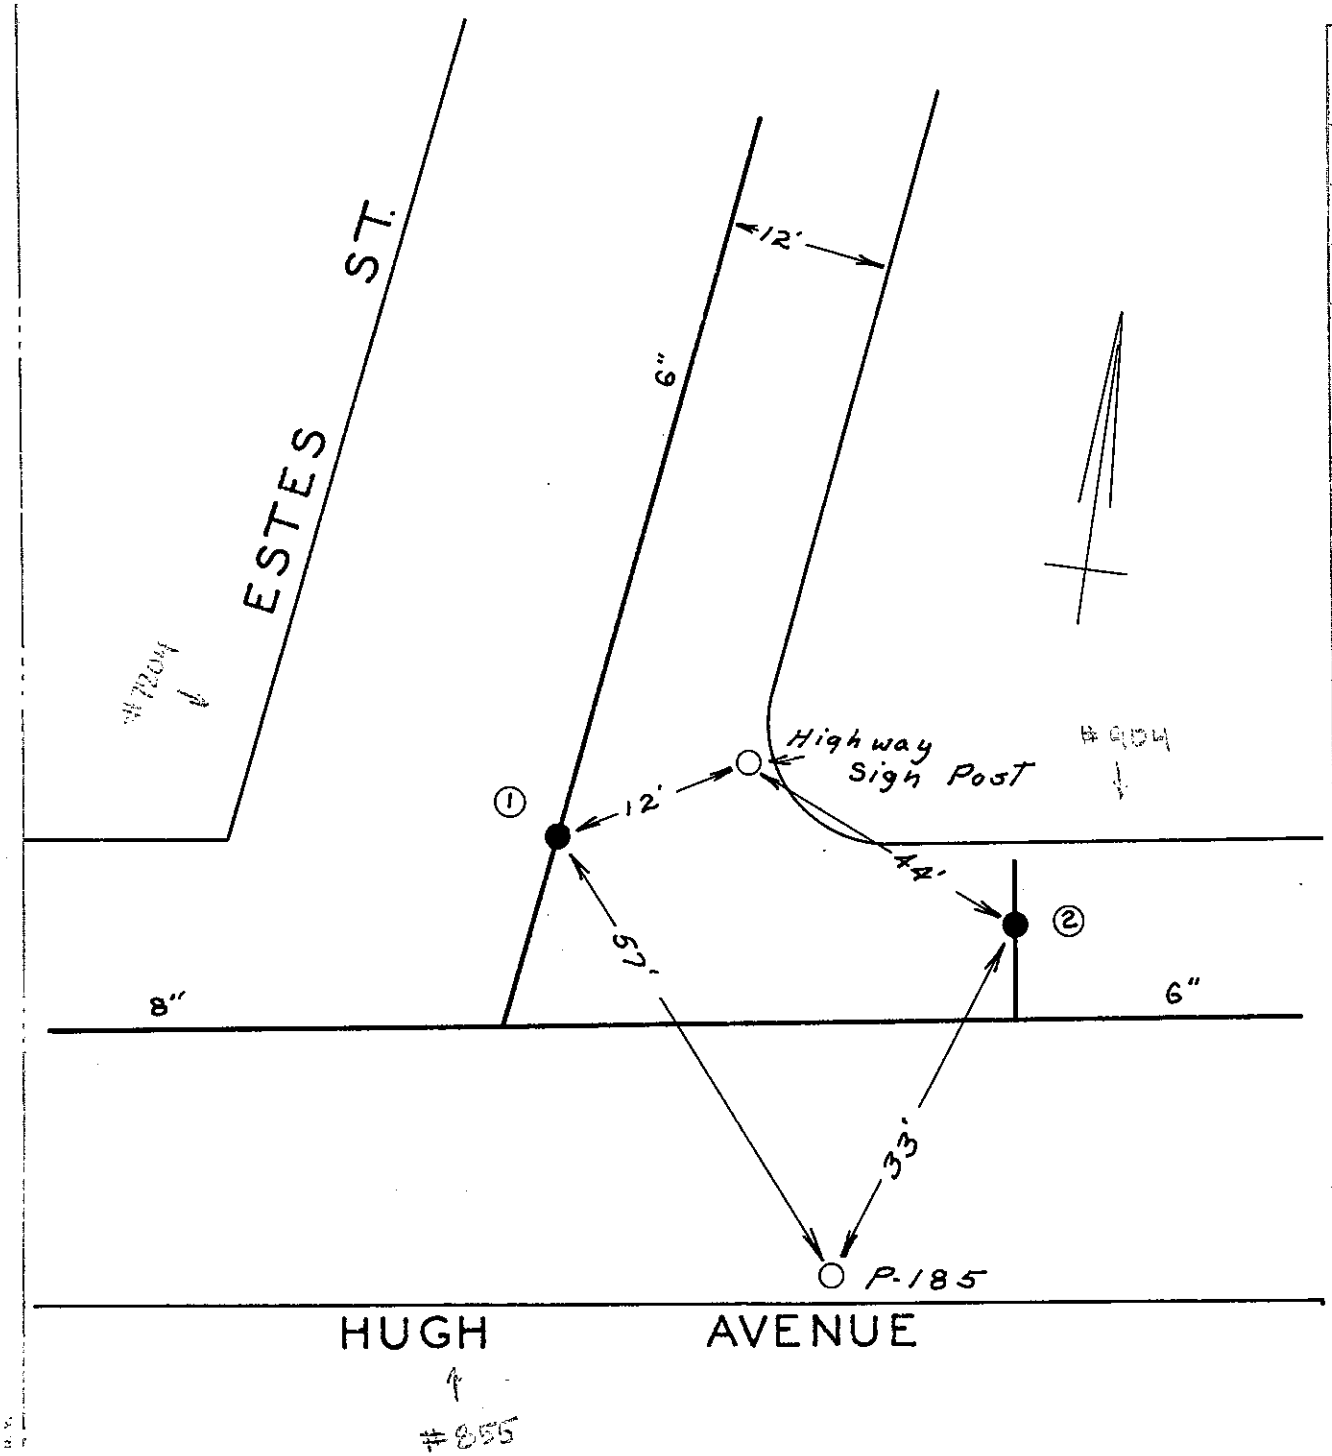

DATE	NO	SIZE	MAKE	OPEN	TURNS
	1	6"			
	2	6"	H-Stub		
	1	0	NPL		

CITY OF ROANOKE — WATER DEPT.

VALVE DIAGRAM

ESTES ST. & HUGH AVE. N. E.

SEC. MAP 18 Roanoke County

DATE PAGE NO.