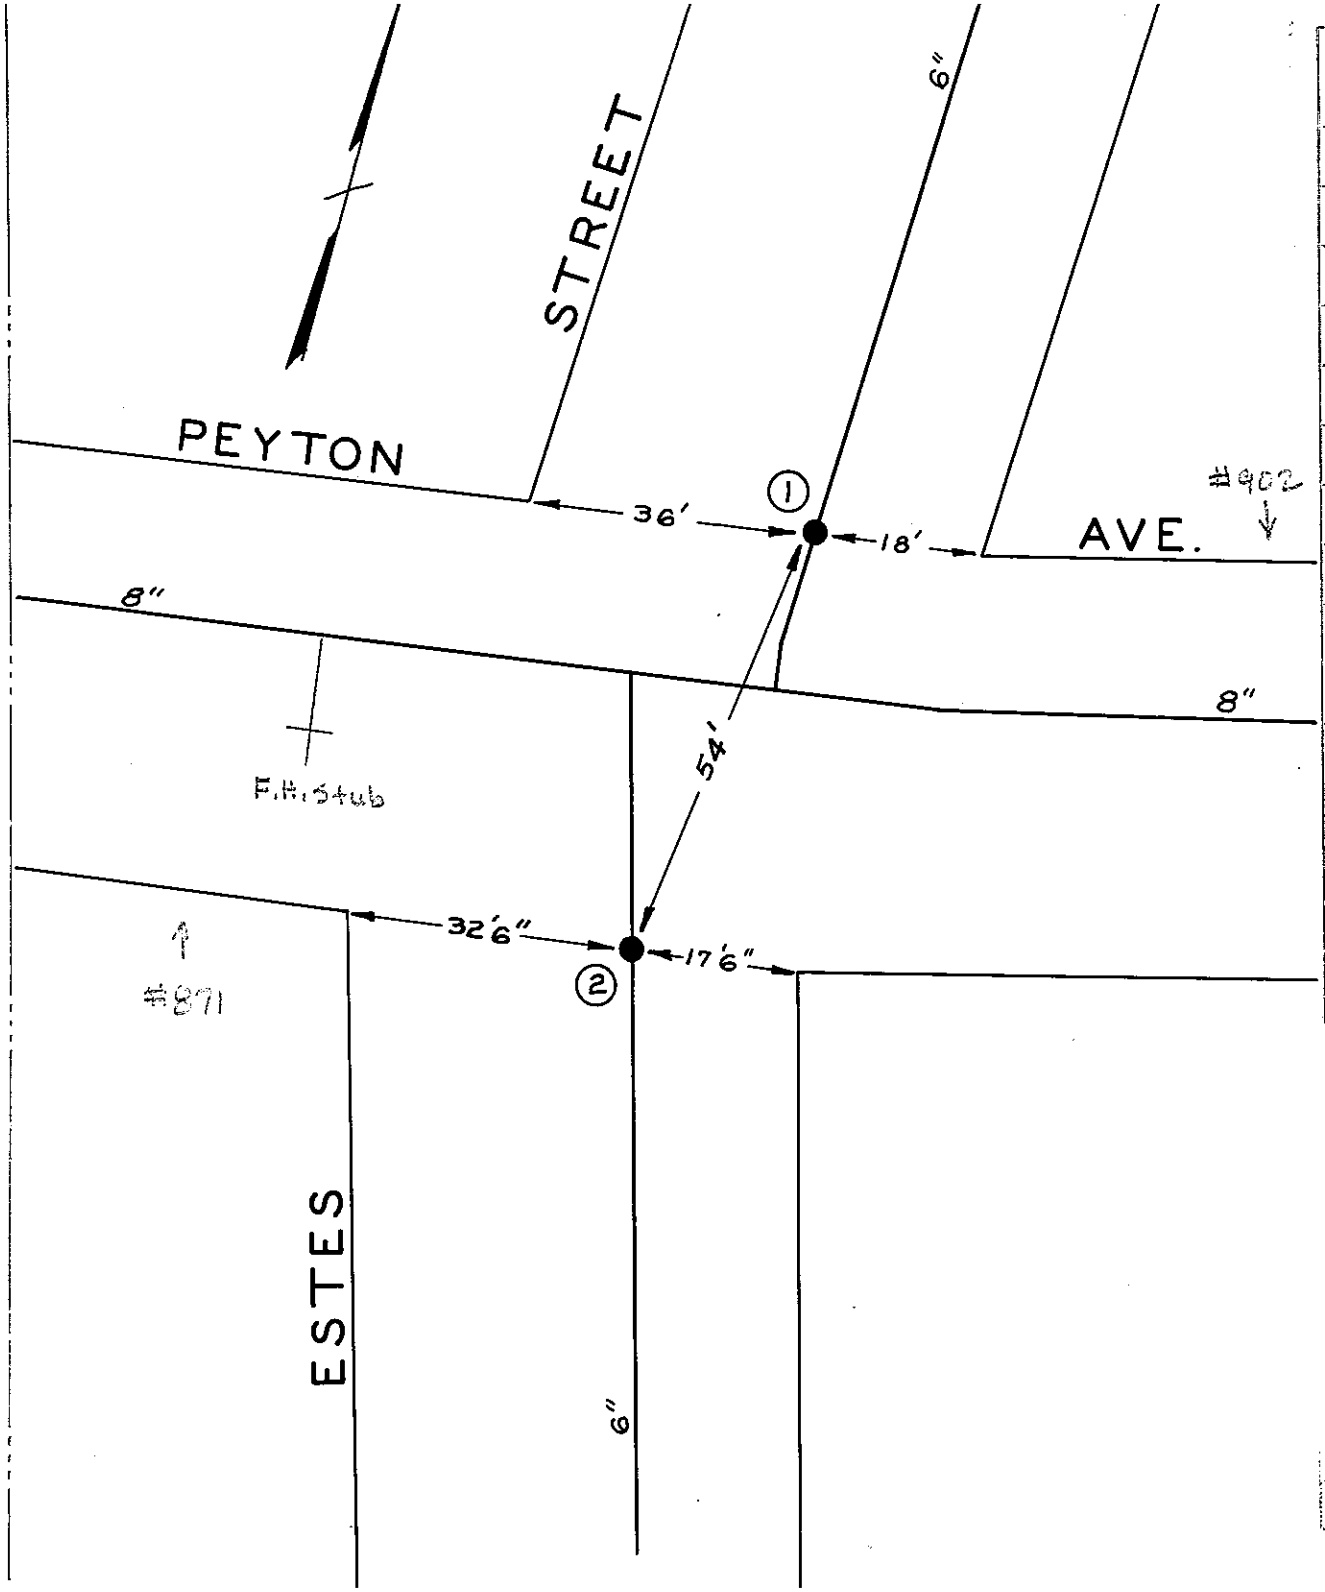

DATE	NO.	SIZE	MAKE	OPEN	TURNS
'59	1	6"	MUELLER	R	20½
'59	2	6"	MUELLER	R	20½
	1	0	NPL		
	2	0	SPL		

CITY OF ROANOKE—WATER DEPT.
VALVE DIAGRAM

ESTES ST. & PEYTON AVENUE N.E.

SEC. MAP 18 Roanoke County

DATE PAGE NO.

"IMPERIAL" TRACING CLOTH K & E CO., N.Y.