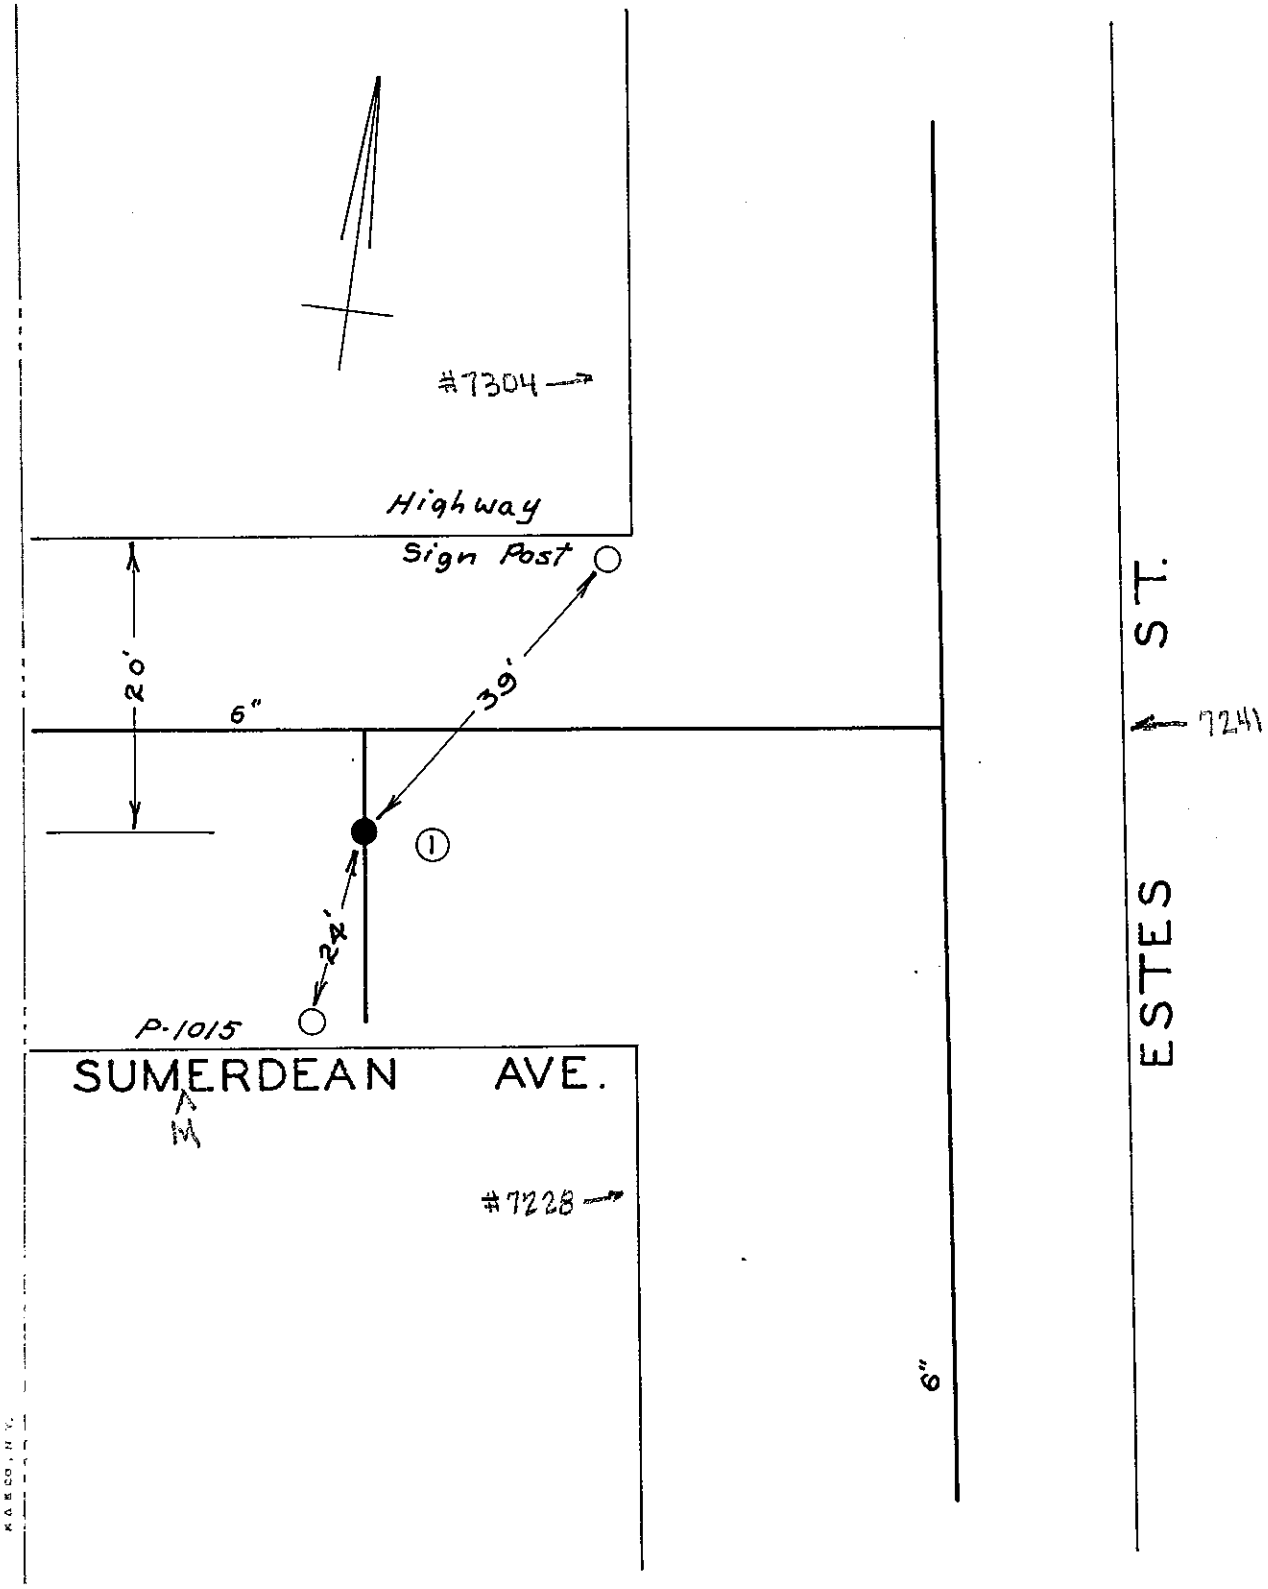

DATE	NO.	SIZE	MAKE	OPEN	TURNS
	1	6"	H. Stub		

CITY OF ROANOKE — WATER DEPT.

VALVE DIAGRAM

ESTES ST. & SUMMERDEAN AVE. N.E.

SEC. MAP 18 Roanoke County

DATE PAGE NO.