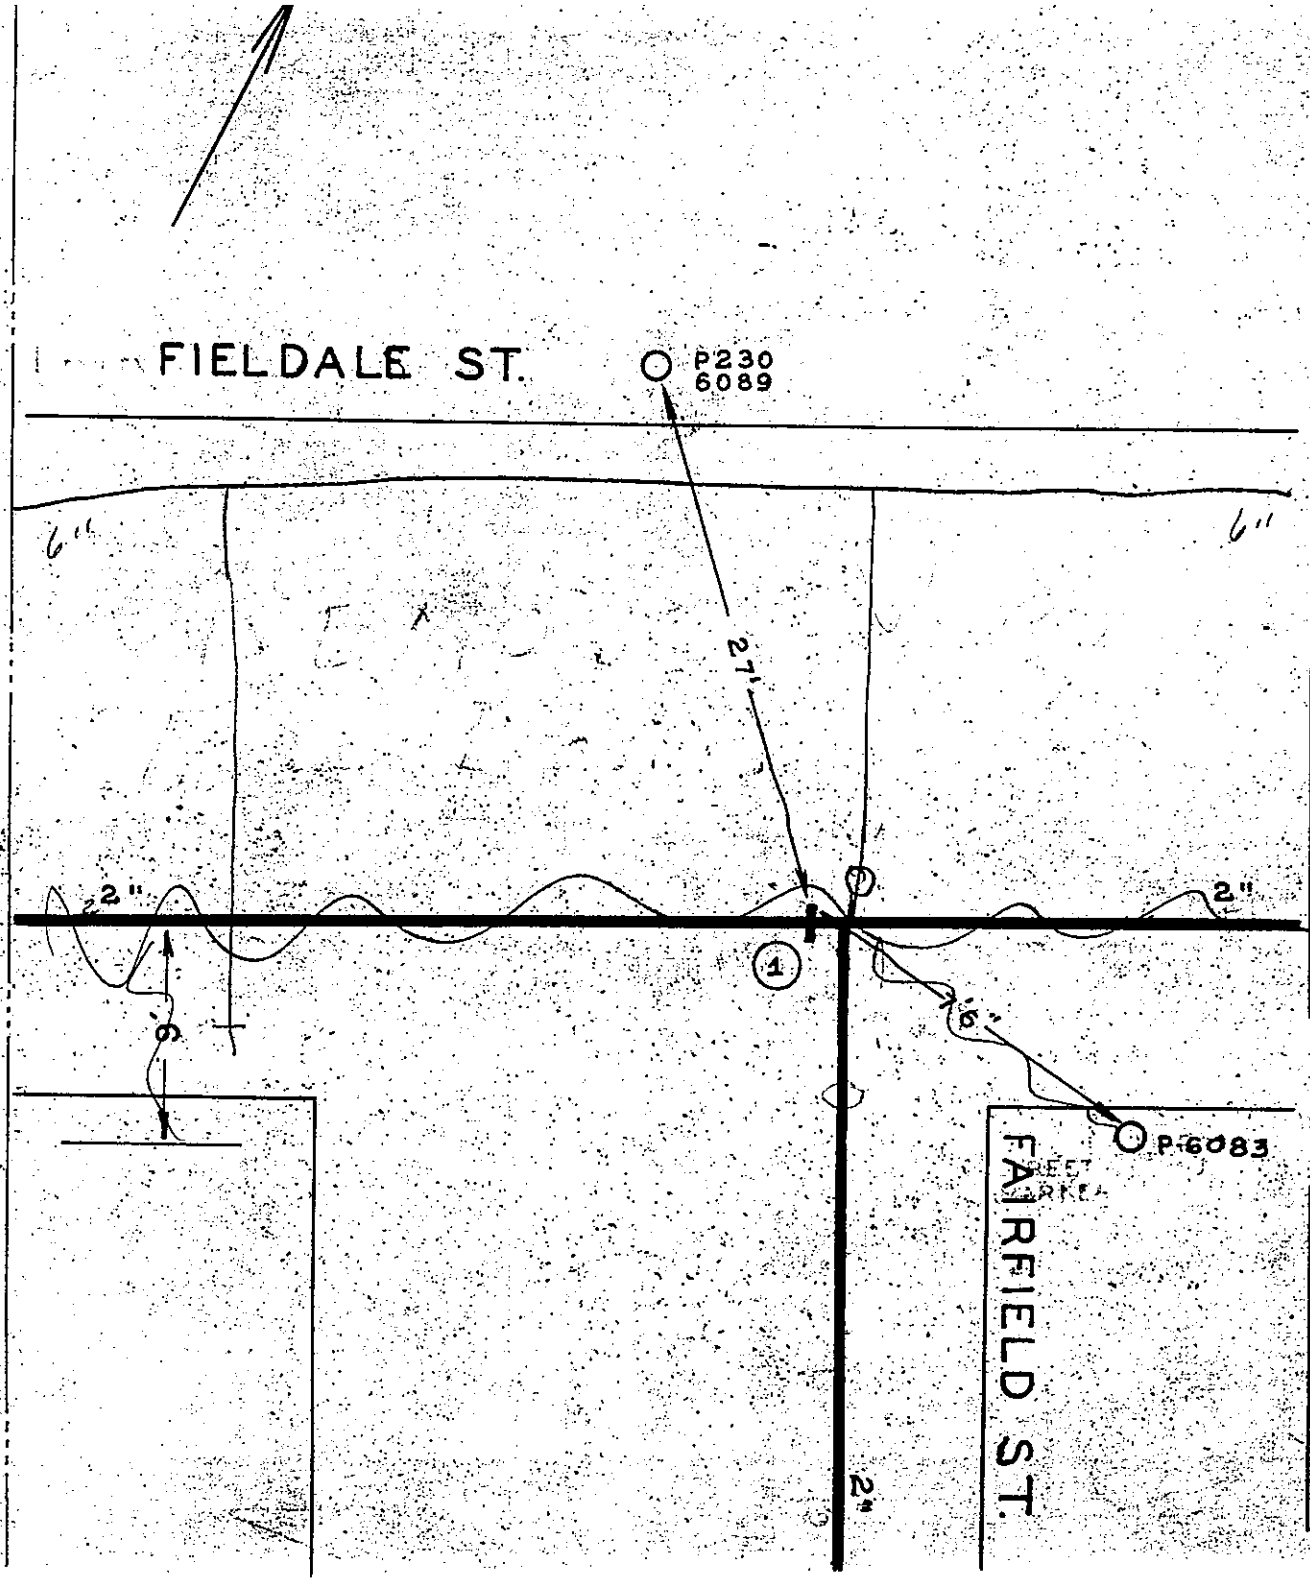

DATE	NO.	SIZE	MAKE	OPEN	TURNS
~~[illegible]~~	1	2"			
	1	2-W	EPI		

need new maps 4/89

CITY OF ROANOKE—WATER DEPT.

VALVE DIAGRAM

FAIRFIELD ST.VE &

FAIRDALE STAD N.E.

SEC. MAP 310

DATE W.R.T. PAGE NO. NE 195

"IMPERIAL" TRACING CLOTH
K & E CO., N. Y.