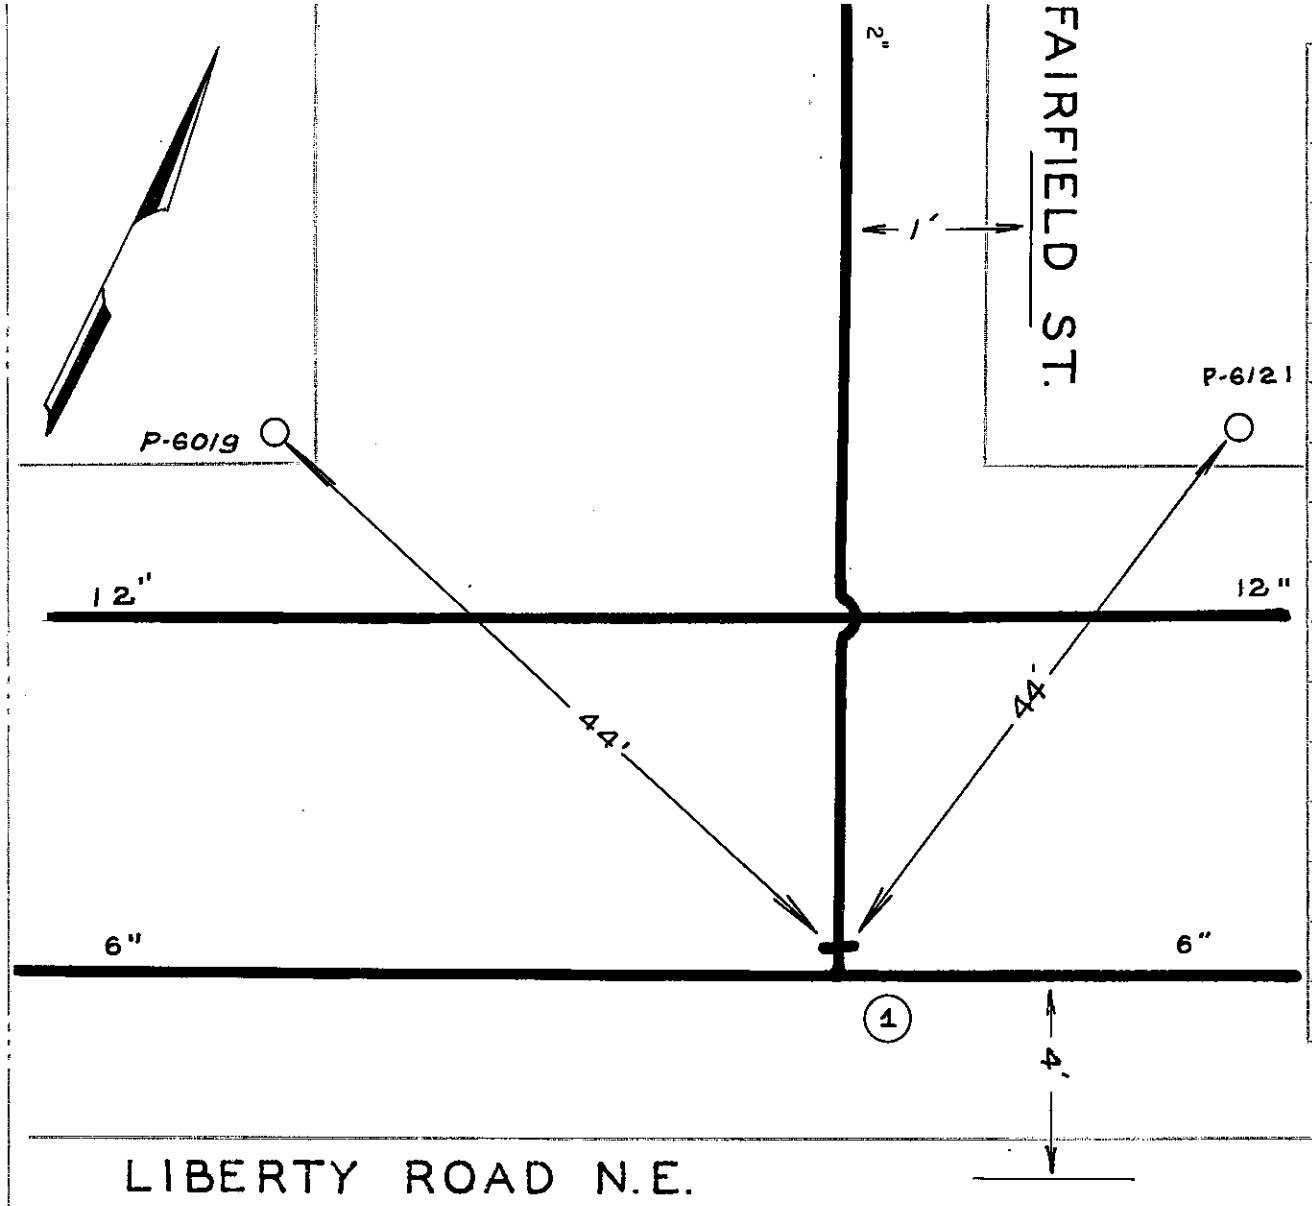

DATE	NO.	SIZE	MAKE	OPEN	TURNS
W.R. 1951	1	2"		R	
	1	4'-N	SPL		

CITY OF ROANOKE – WATER DEPT.

VALVE DIAGRAM

FAIRFIELD ST. &

LIBERTY ROAD

SEC. MAP 310, 313 N.E.

DATE W.R. PAGE NO. NE202

10/2000 JH