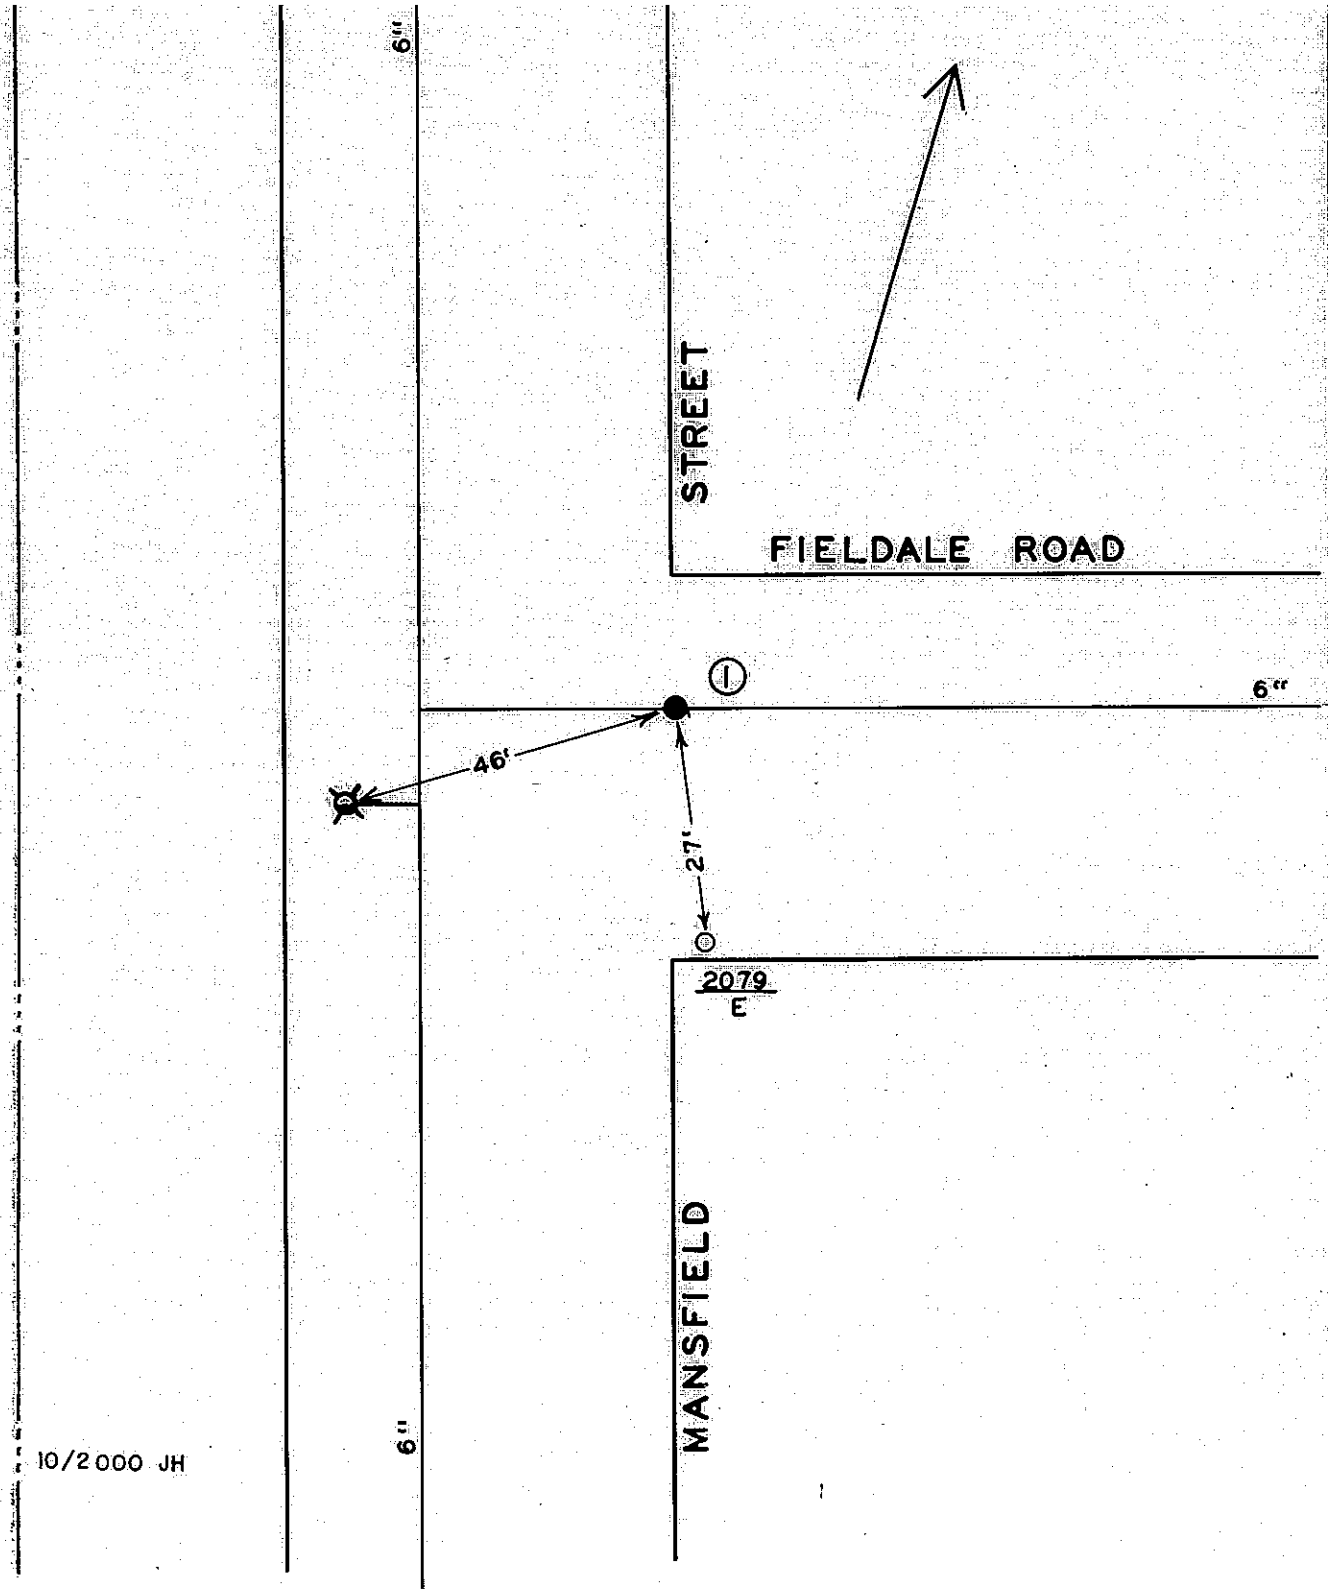

DATE	NO.	SIZE	MAKE	OPEN	TURNS
10-62	1	6"	DARLING	R	
	1	0	E.P.L.		

CITY OF ROANOKE—WATER DEPT.

VALVE DIAGRAM

FIELDALE ROAD &

MANSFIELD STREET

SEC. MAP 310 N.E.

DATE PAGE NO.

10/2000 JH