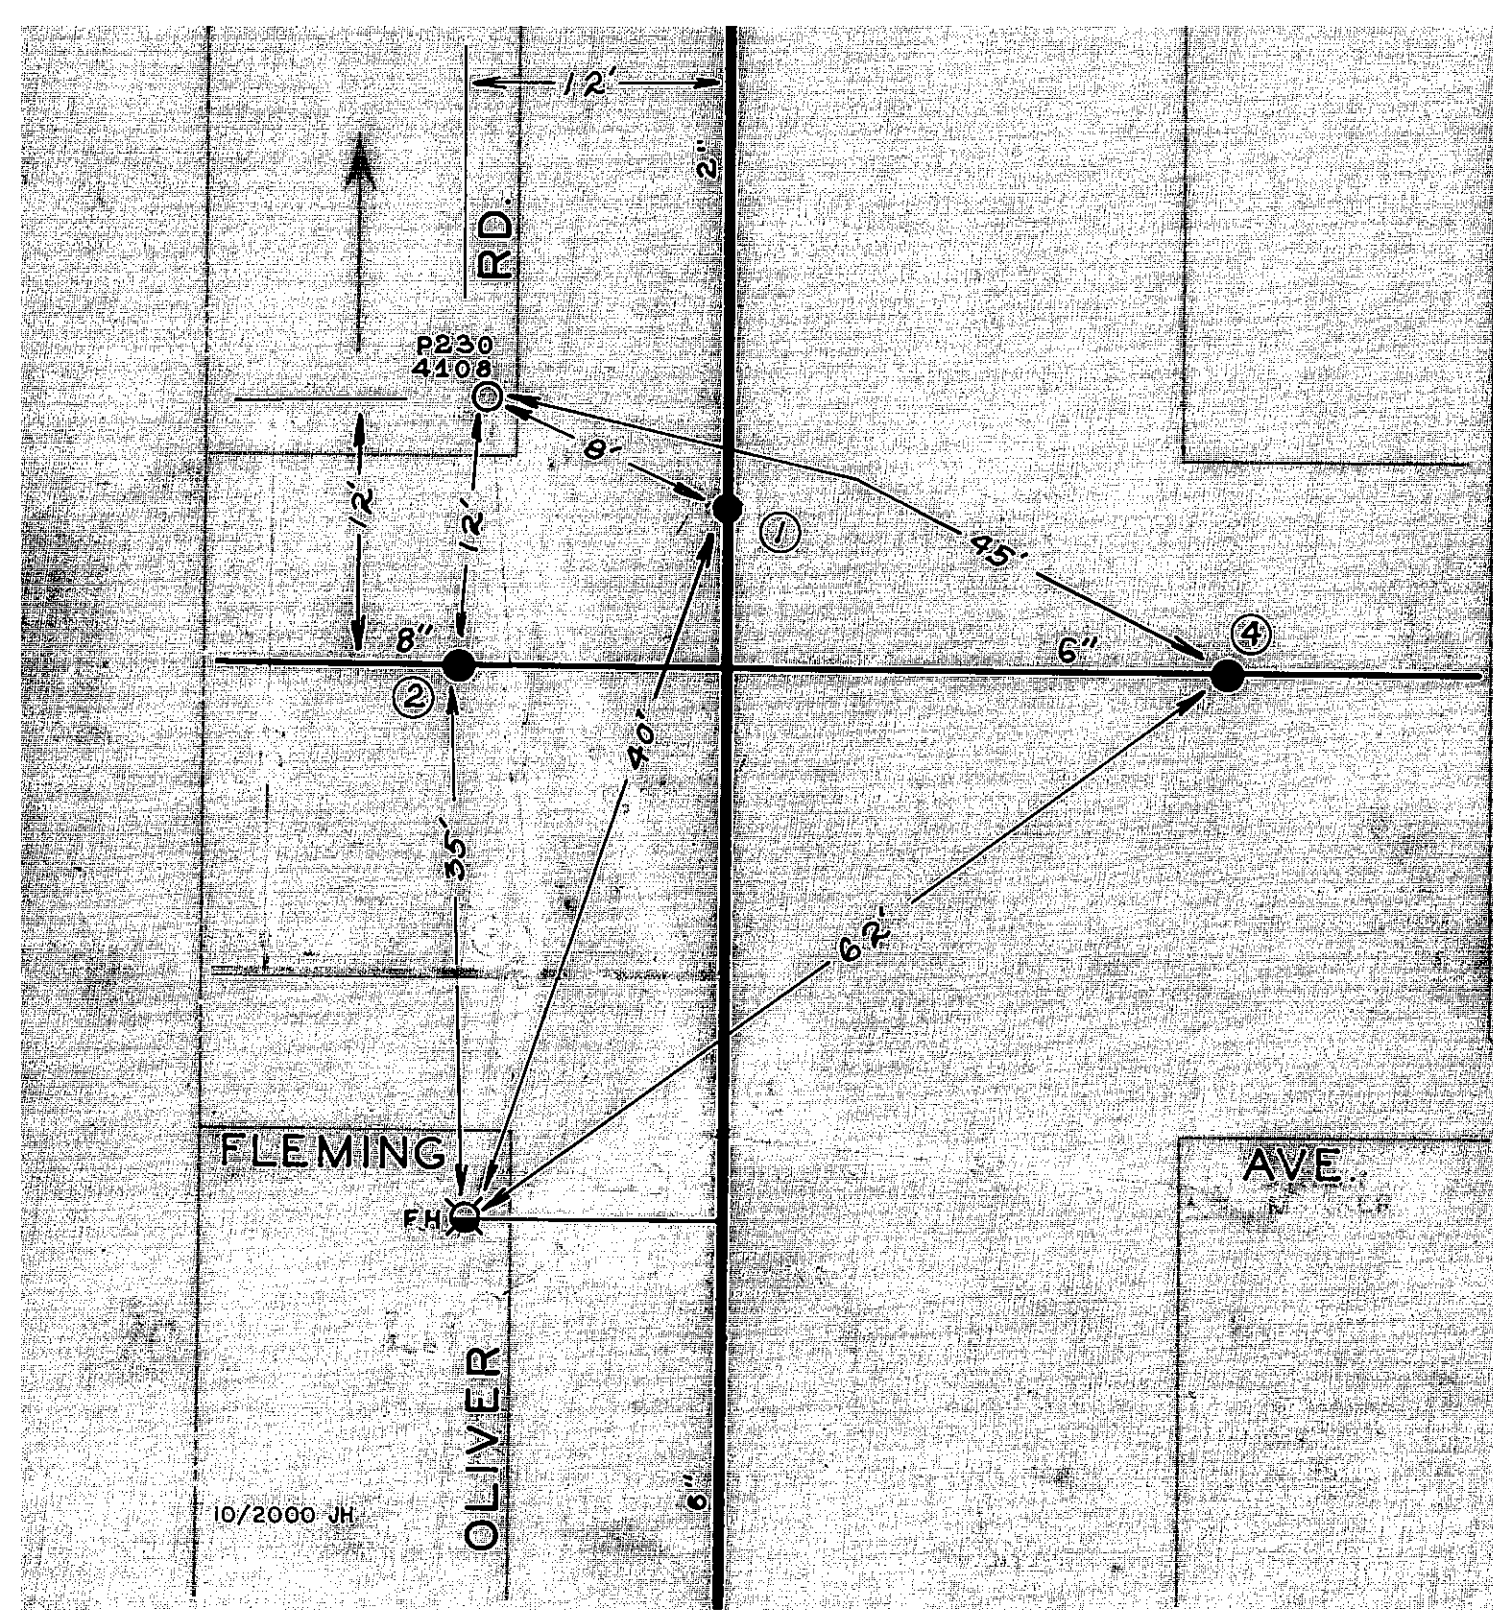

DATE	NO.	SIZE	MAKE	OPEN	TURNS
W.R. 1951	1	2"		R	
1953	2	8"		R	
1952	4	6"		R	

1 10-S NPL

2 0 WPL

4 0 EPL

CITY OF ROANOKE - WATER DEPT.

VALVE DIAGRAM

FLEMING AVENUE

& OLIVER ROAD

SEC. MAP 318 N.E.

DIST. WR PAGE NO. NE-182