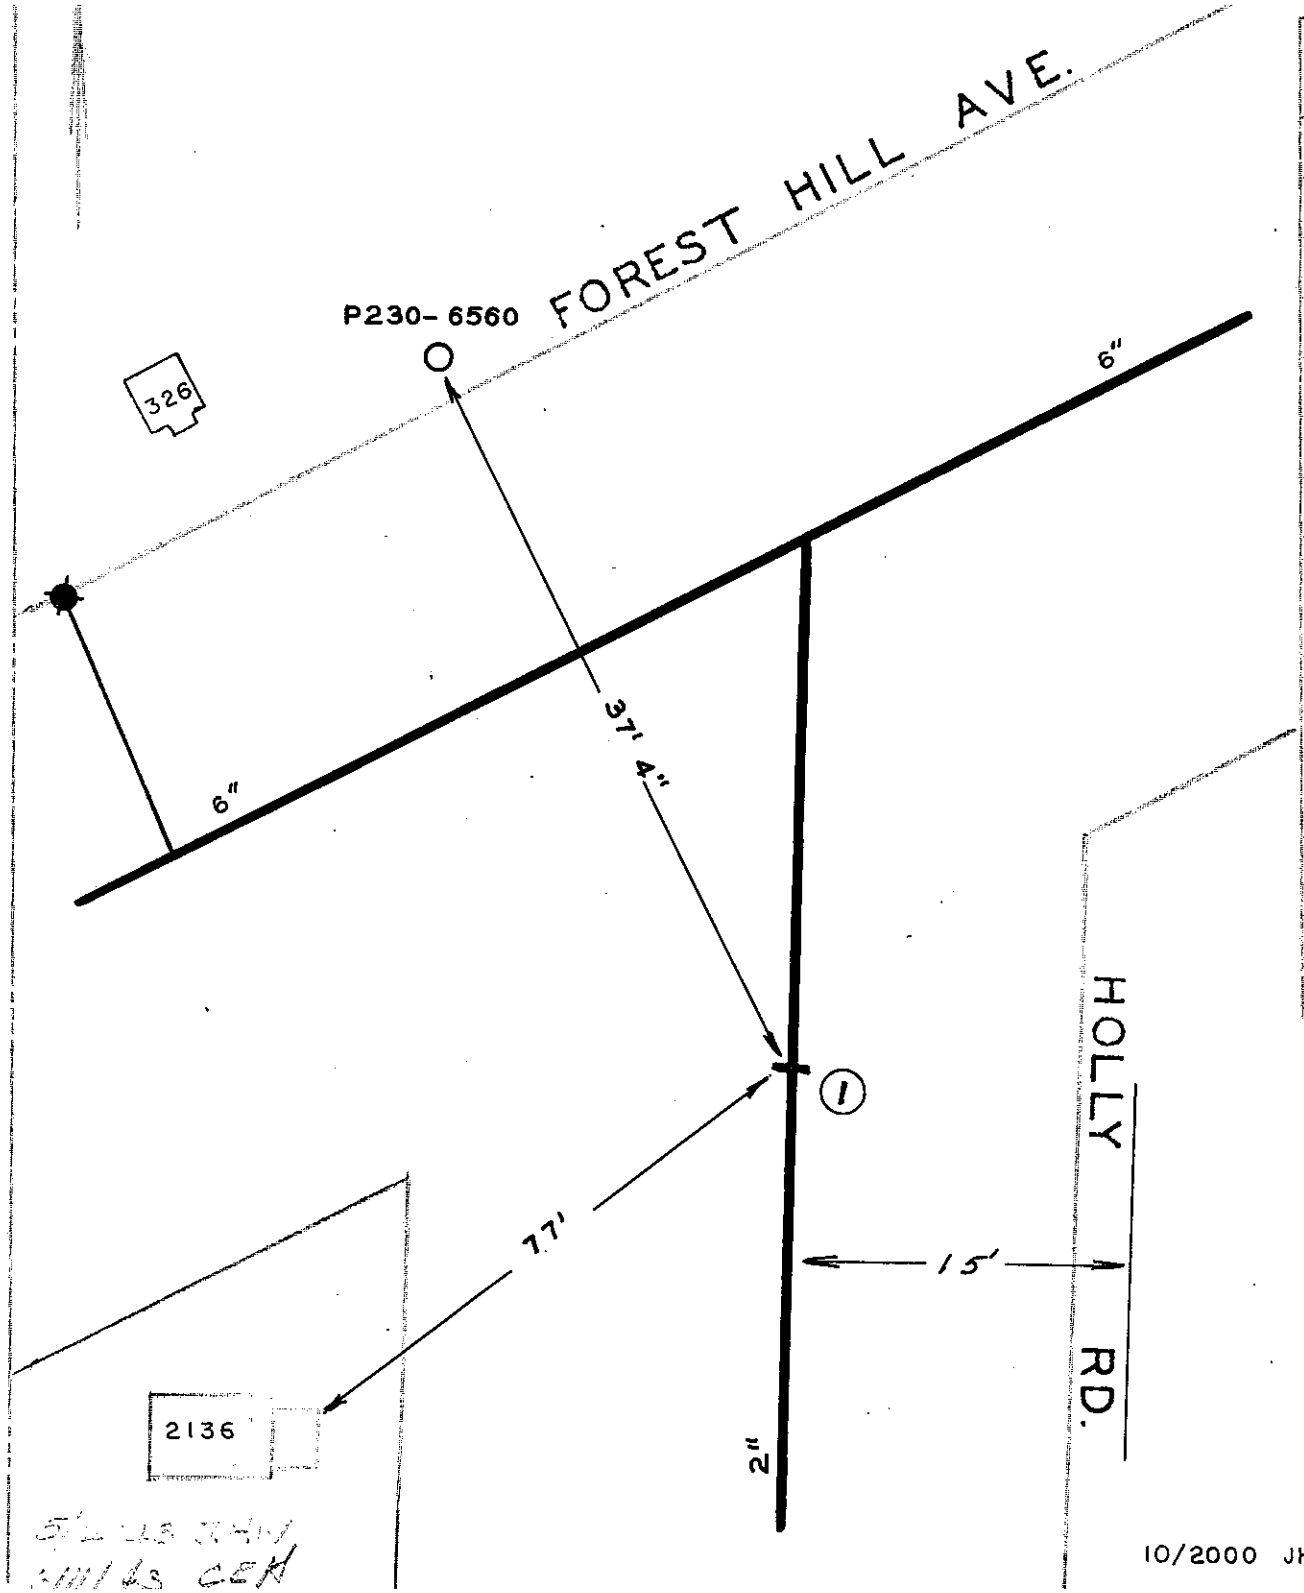

DATE	NO	SIZE	MAKE	OPEN	TURNS
1938	1	2"		R	7
	1	0	SPL		

CITY OF ROANOKE—WATER DEPT

VALVE DIAGRAM

FOREST HILL AVENUE & HOLLY ROAD

SEC MAP 308, 309 N.E.

DATE PAGE No NE 89

10/2000 JH