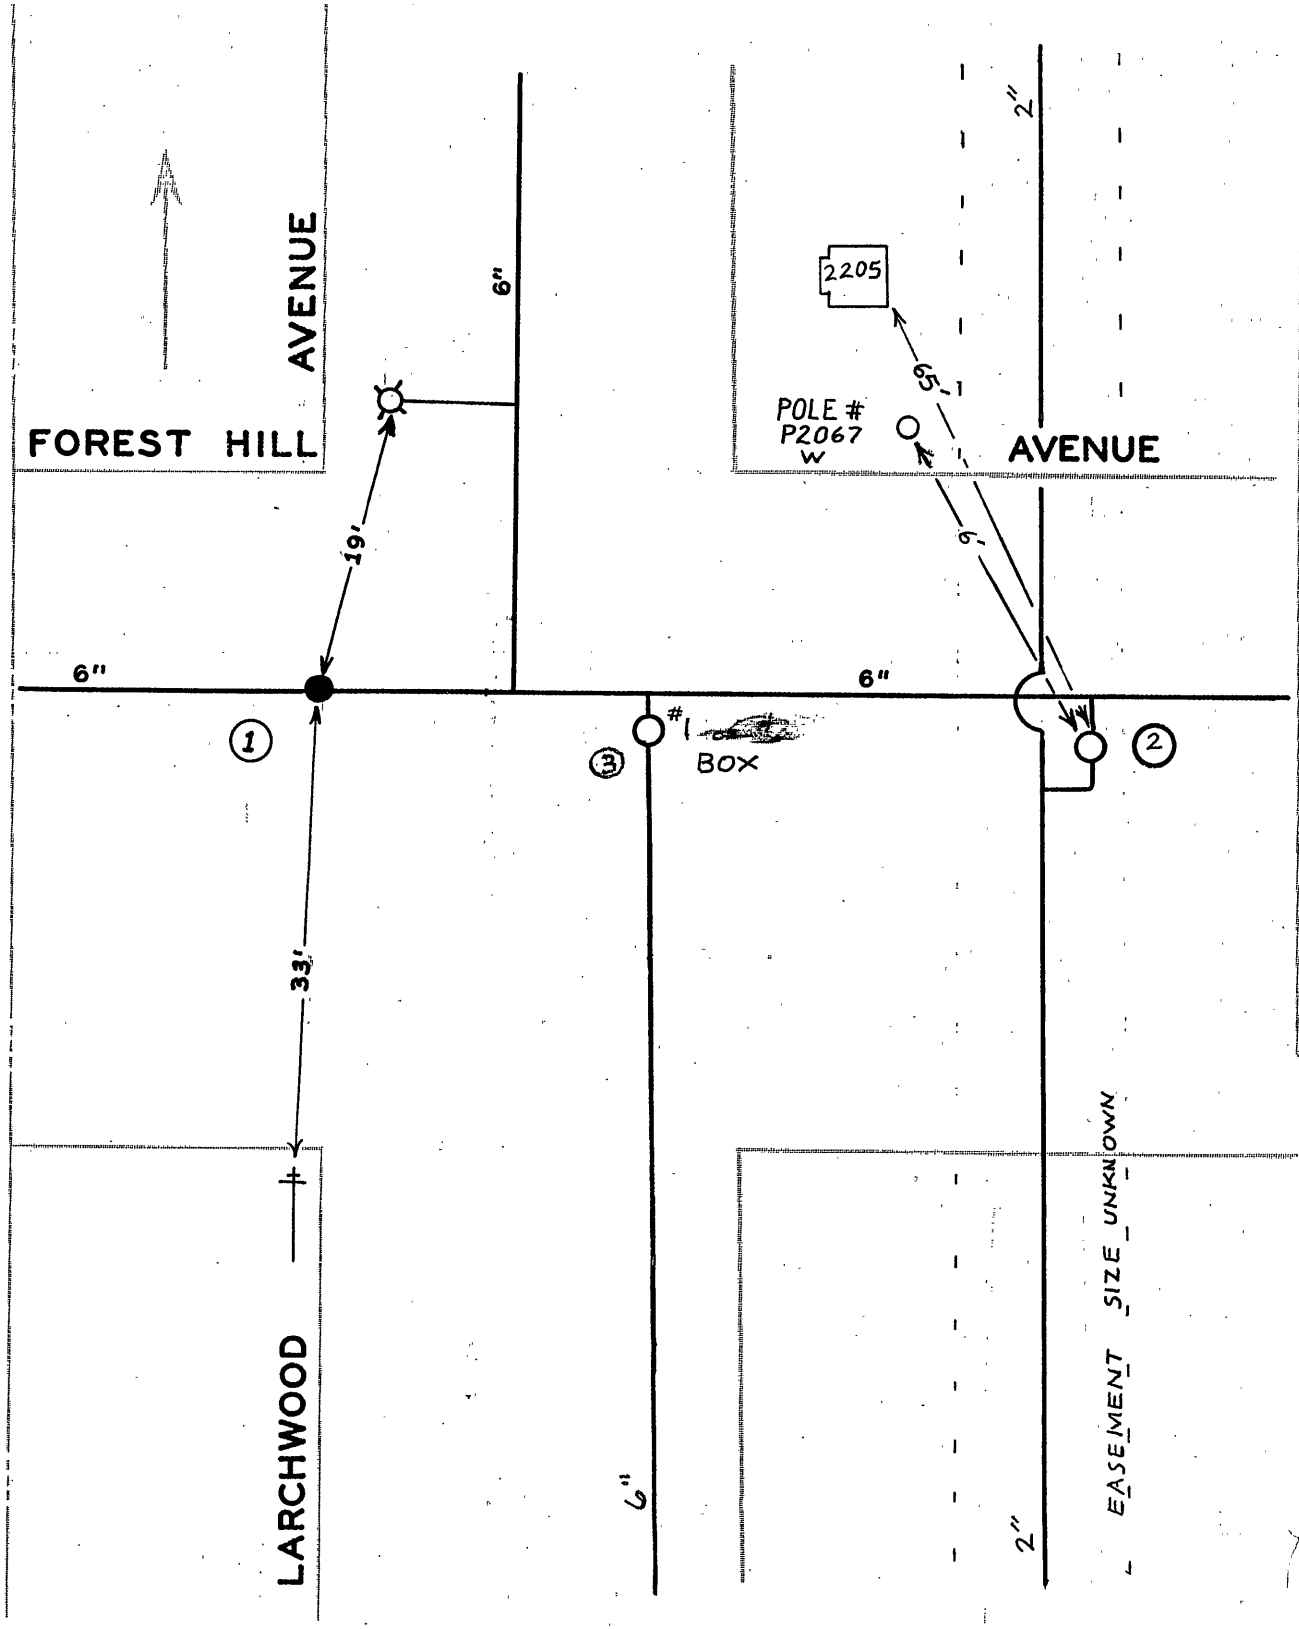

DATE	NO.	SIZE	MAKE	OPEN	TURNS
6-60	1	6"	MUELLER	R	
1951 W.R.	2	2"			
51 1995	3	6"			
	1	0'	W.P.L.		

CITY OF ROANOKE--WATER DEP'T

VALVE DIAGRAM

FOREST HILL AVENUE &

LARCHWOOD AVENUE N.E.

SEC. MAP 309,

DATE PAGE NO.

7/2000 JH