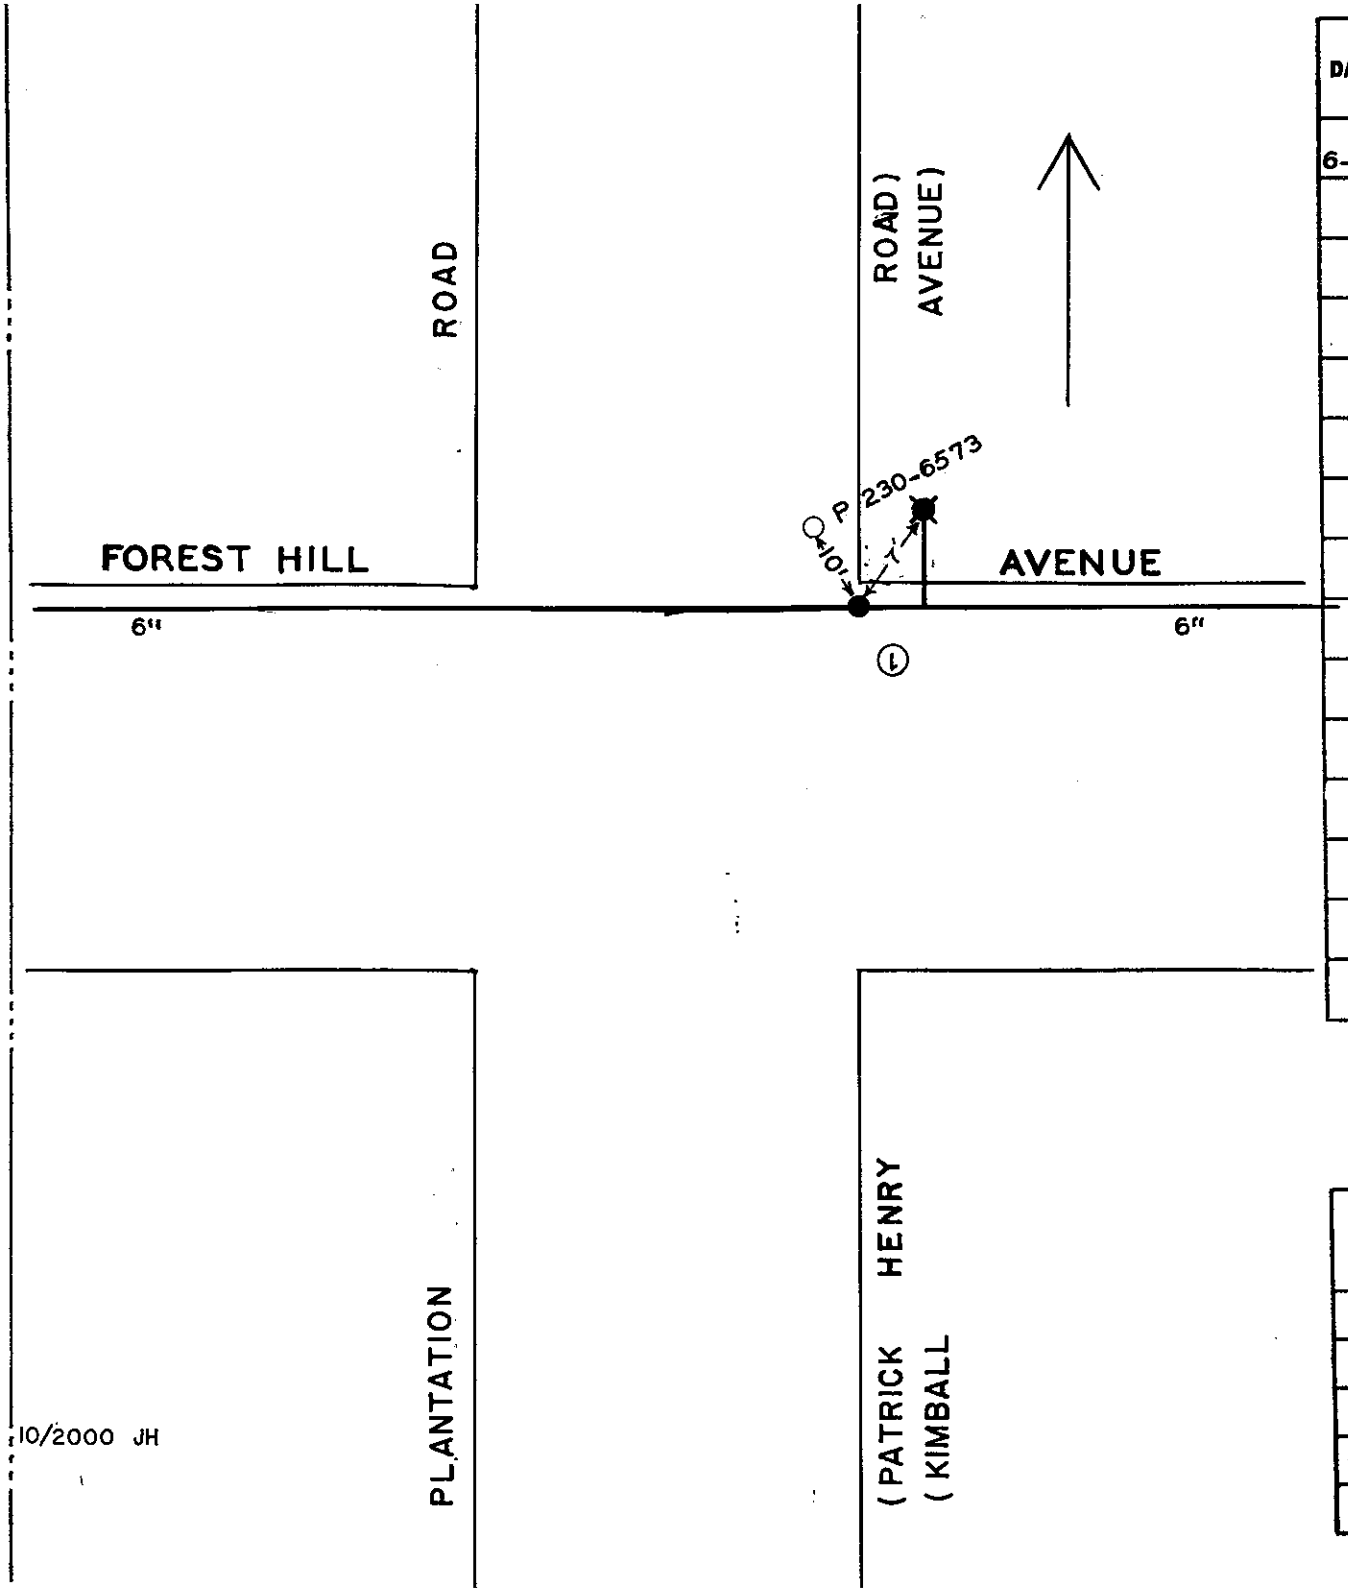

DATE	NO.	SIZE	MAKE	OPEN	TURNS
6-62	1	6"	DARLING	R	20
	1	0	E.P.L.		

CITY OF ROANOKE—WATER DEPT.

VALVE DIAGRAM

FOREST HILL AVENUE &
PLANTATION ROAD

SEC. MAP 312 N.E.

DATE PAGE NO.