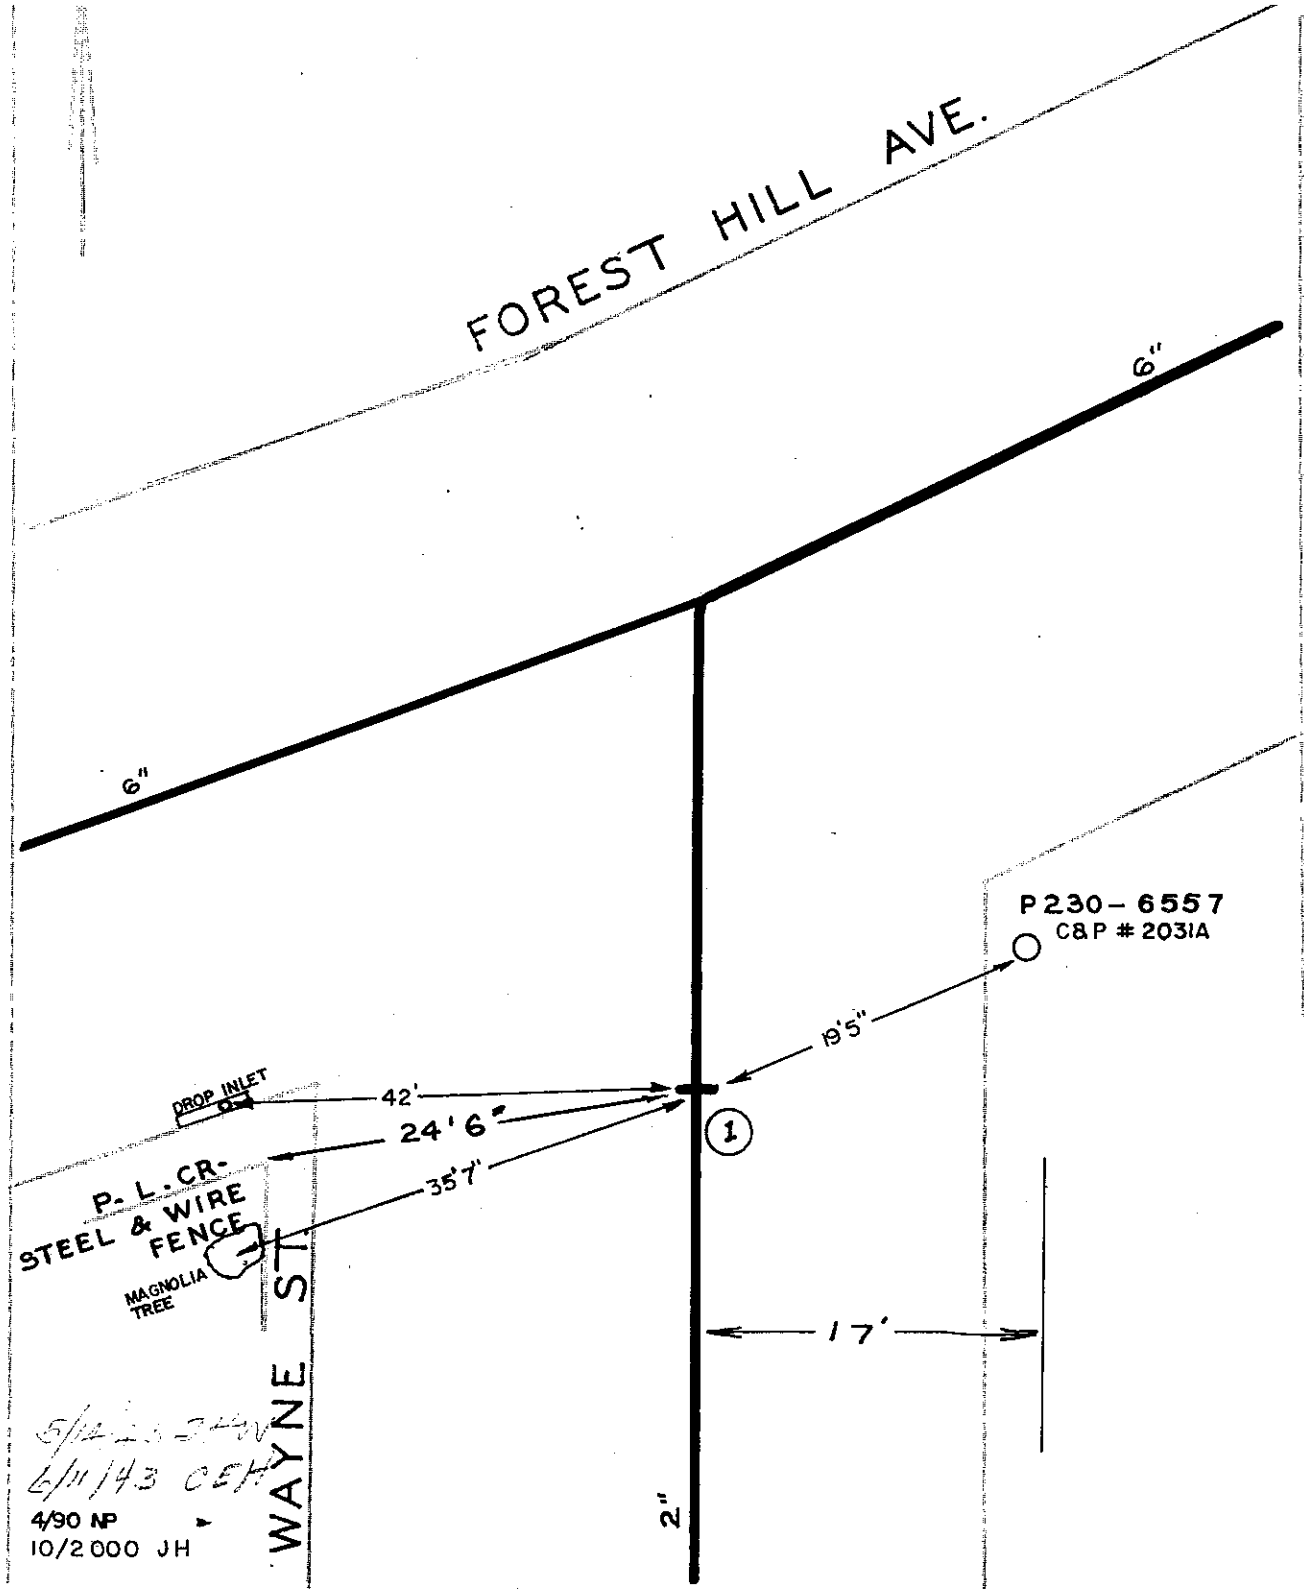

DATE	NO	SIZE	MAKE	OPEN	TURNS
1927	1	2"		R	7
	1	76'-S	SPL		

CITY OF ROANOKE - WATER DEP'T

VALVE DIAGRAM

FOREST HILL AVENUE & WAYNE STREET

SEC. MAP 308 309 N.E.

DATE PAGE NO. NE 88