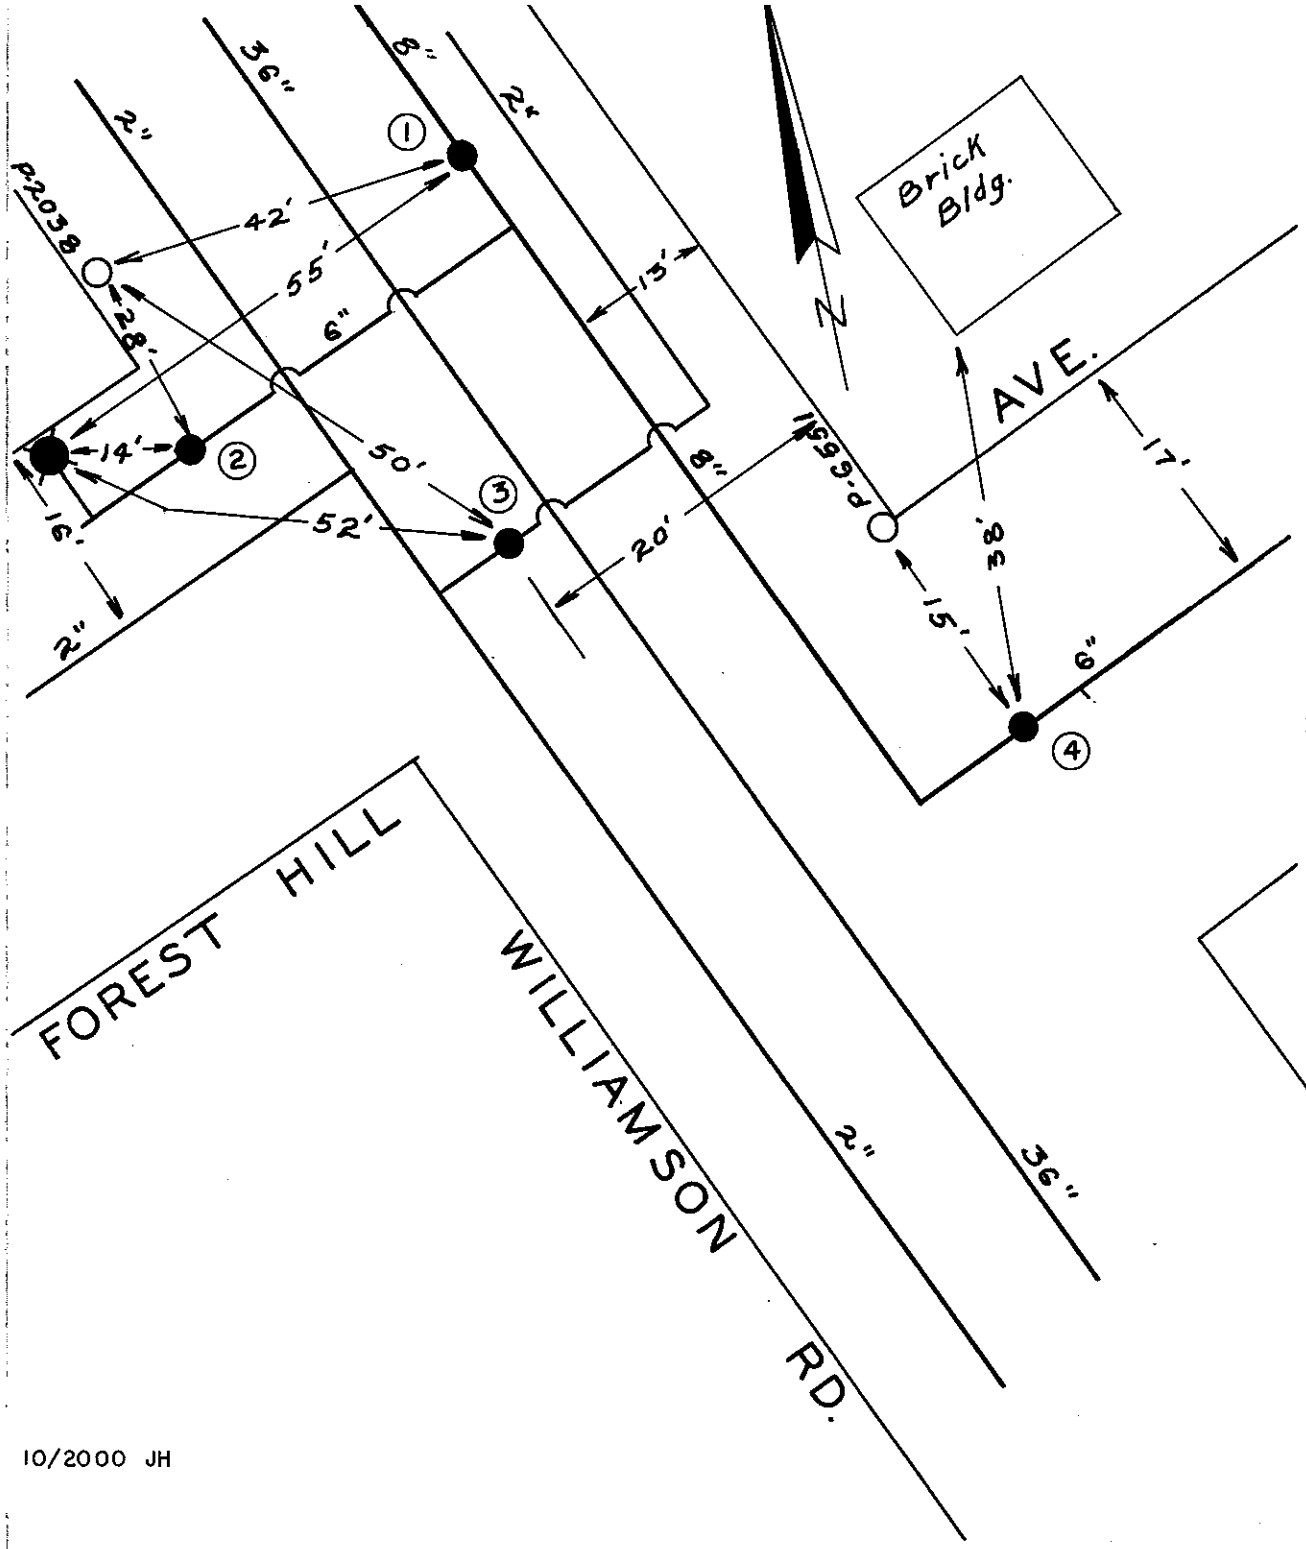

DATE	NO.	SIZE	MAKE	OPEN	TURNS
1953	1	8"	MUELLER	R	27
1953	2	6"	MUELLER	R	20
1926	3	2"	DARLING	R	7
1953	4	6"	MUELLER	R	20
	1	0	N PL		
	2	0	W PL		
	3	24'-S	W PL		
	4	0	E PL		

CITY OF ROANOKE – WATER DEPT.

VALVE DIAGRAM

FOREST HILL AVE. &

WILLIAMSON RD.

SEC. MAP 308 N.E.

DATE PAGE NO.

10/2000 JH